


STATE OF KANSAS
STATE CORPORATION COMMISSION

Give All Information Completely
Make Required Affidavit
Mail or Deliver Report to:
Conservation Division
State Corporation Commission
800 Bitting Building
Wichita, Kansas

WELL PLUGGING RECORD
OR
FORMATION PLUGGING RECORD

Strike out upper line
when reporting plug-
ging off formations.

NORTH

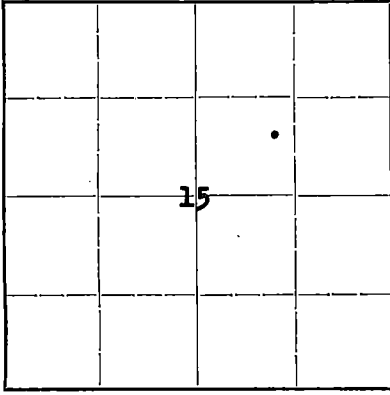

Locate well correctly on above
Section Plat

Rice

County. Sec. 15 Twp. Rge. 19s (E) 10 (W)

Location as "NE 1/4 NW 1/4 SW 1/4" or footage from lines. C E/2 SW/4 NE/4

Lease Owner Hollow Drilling Company, Inc.

Lease Name J. Gill Well No. 1

Office Address Box 730, Wichita 1, Kansas

Character of Well (completed as Oil, Gas or Dry Hole) Dry Hole

Date well completed 8-25 19.43

Application for plugging filed 8-25 19.43

Application for plugging approved 8-25 19.43

Plugging commenced 8-25 19.43

Plugging completed 8-25 19.43

Reason for abandonment of well or producing formation Dry Hole

If a producing well is abandoned, date of last production 19

Was permission obtained from the Conservation Division or its agents before plugging was commenced? Yes

Name of Conservation Agent who supervised plugging of this well Ruel Durkee

Producing formation Depth to top Bottom Total Depth of Well Feet

Show depth and thickness of all water, oil and gas formations.

OIL, GAS OR WATER RECORDS

CASING RECORD

| Formation | Content | From | To | Size | Put In | Pulled Out |
|-----------|---------|------|------|-------|--------|------------|
| Surface | Water | 0 | 240 | 8 5/8 | 240 | None |
| T. D. | | | 3317 | -- | -- | -- |
| | | | | | | |
| | | | | | | |
| | | | | | | |
| | | | | | | |
| | | | | | | |

Describe in detail the manner in which the well was plugged, indicating where the mud fluid was placed and the method or methods used in introducing it into the hole. If cement or other plugs were used, state the character of same and depth placed, from feet to feet for each plug set.

Hole pumped full heavy mud to 235'. Wood plug and 10 sacks cement bridge placed

235--200. Cement placed through drill pipe. Heavy mud filled on bridge to 20'.

Wood plug and 5 sacks cement bridge placed 20 to bottom of cellar.

9-8-1943

PLUGGING
FILE NO. 15-19-100
DOK PAGE 89-ONE-12

(If additional description is necessary, use BACK of this sheet)

Correspondence regarding this well should be addressed to HOLLOW DRILLING COMPANY, Inc.

Address Box 730
Wichita 1, Kansas

STATE OF Kansas, COUNTY OF Sedgwick, ss.

Frank Leach

(employee of owner) or (owner or operator) of the above-described well,

being first duly sworn on oath, says: That I have knowledge of the facts, statements, and matters herein contained and the log of the above-described well as filed and that the same are true and correct. So help me God.

(Signature)

Box 730, Wichita 1, Kansas

(Address)

SUBSCRIBED AND SWORN TO before me this 27 day of August, 1943

My commission expires February 4, 1946



HOLLOW DRILLING COMPANY, Inc.

Jennie Gill #1---- C E/2 SW/4 NE/4
15-19s-10w
Rice County, Kansas

Date Commenced---- July 27, 1943
Date Completed---- August 25, 1943

Elevation----- 1752' L & S.

Tools----- Rotary.

Owner----- Hollow Drilling Company, Inc., et al
Wichita, Kansas.

Casing Record:

8 5/8" cemented @ 240' w/ 225 sacks.

LOG

| | | |
|------|------|---------------------|
| 0 | 120 | Sand |
| 120 | 220 | Shale & Shells |
| 220 | 440 | Red Rock |
| 440 | 465 | Anhydrite |
| 465 | 555 | Red Rock & Shale |
| 555 | 1040 | Shale & Shells |
| 1040 | 1260 | Salt & Shale |
| 1260 | 1300 | Lime |
| 1300 | 1405 | Shale & Lime Shells |
| 1405 | 1440 | Shale & Lime |
| 1440 | 1465 | Sand & Shale |
| 1465 | 1520 | Shale & Shells |
| 1520 | 1605 | Broken Lime & Shale |
| 1605 | 1735 | Lime |
| 1735 | 1870 | Lime & Shale |
| 1870 | 1905 | Lime |
| 1905 | 2160 | Lime & Shale |
| 2160 | 2310 | Shale & Shells |
| 2310 | 2425 | Lime Shells & Shale |
| 2425 | 2540 | Lime & Shale |
| 2540 | 2756 | Lime |
| 2756 | 2780 | Lime "Cherty" |
| 2780 | 2825 | Lime & Shale |
| 2825 | 2905 | Shale & Sand |
| 2905 | 2963 | Shale & Shells |
| 2963 | 3088 | Lime |
| 3088 | 3120 | Shale |
| 3120 | 3159 | Lime |
| 3159 | 3247 | Lime & Shale |
| 3247 | 3317 | Lime |
| 3317 | | T.D. |

GEOLOGICAL TOPS (D.F.)

| | |
|---------------------|------|
| Top Stone Corral | 440 |
| Top Winfield | 1440 |
| Top Ft. Riley | 1520 |
| Top Florence Flint | 1625 |
| Base Florence Flint | 1645 |
| Top Wreford | 1670 |
| Base Wreford | 1700 |
| Top Topeka | 2570 |
| Top "Brown" Lime | 2931 |
| Top Lansing | 2955 |
| Top Conglomerate | 3275 |
| Top Arbuckle | 3290 |

FILE 15-19-10w
BOOK PAGE 89 12

This is to certify that this is a true and correct copy of the log of the Jennie Gill #1 as described above.

Frank Leach

Frank Leach

Hollow Drilling Company, Inc.

HOLLOW-BUILDING

~~INMAN, - KANSAS~~
Schweiter Building
Wichita, Kansas

IN REPLY REFER TO:

Sept. 1, 1943

In Re: J. Gill #1
C E/2 SW/4 NE/4
15-19s-10w
Rice County, Kans.

State Corporation Commission,
Conservation Division,
800 Bitting Building,
Wichita, Kansas.

Gentlemen:

In connection with the plugging of the above captioned dry hole test, we enclose the following --

1. Well Plugging Application Form
2. Executed Well Plugging Record
3. Log

This completes all information necessary to complete the records for the above dry and abandoned test well.

Very truly yours

HOLLOW DRILLING COMPANY, INC.

By Ray-h-rt

RN/bls

enc. (3)

| | |
|----------|-----------------|
| PLUGGING | |
| FILE | 15-19-R-10w |
| BOOK | PAGE 89 LINE 12 |

RECEIVED
SEP 8 - 1943
GENERAL INVESTIGATION
DIVISION