

STATE OF KANSAS  
STATE CORPORATION COMMISSION


WELL PLUGGING RECORD  
OR  
FORMATION PLUGGING RECORD

Strike out upper line  
when reporting plug-  
ging of formations.

Give All Information Completely  
Make Required Affidavit  
Mail or Deliver Report to:  
Conservation Division  
State Corporation Commission,  
800 Bitting Building  
Wichita, Kansas

Rice County. Sec. 10 Twp. 19 Rge. 10W(E) (W)

NORTH

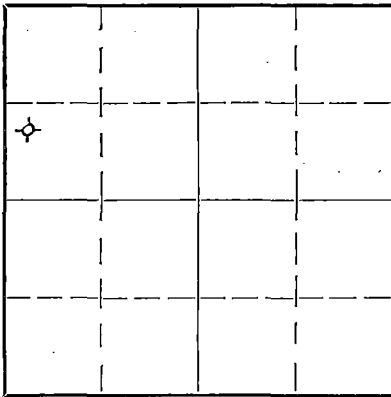

Locate well correctly on above  
Section Plat

Location as "NE $\frac{1}{4}$ NW $\frac{1}{4}$ SW $\frac{1}{4}$ " or footage from lines. NW SW NW  
Lease Owner. Cusco Oil & Refining Co. & Vernon Oil & Gas Co.  
Lease Name. Charles Boldt Well No. 1  
Office Address. Union Nat'l Bnk. Bldg. & 4th. Nat'l Bank Bldg.  
Character of Well (Completed as Oil, Gas or Dry Hole) Dry Hole  
Date, well-completed. March 31st 1936  
Application for plugging filed. April 6th 1936  
Application for plugging approved. " 7th 1936  
Plugging Commenced. April 8th 1936  
Plugging Completed. April 14th 1936  
Reason for abandonment of well or producing formation. Dry Hole - Hole full of  
Water in the Siliceous lime.  
If a producing well is abandoned, date of last production. 1936  
Was permission obtained from the Conservation Division or its agents before plugging was commenced?  
Yes

Name of Conservation Agent who supervised plugging of this well.  
Producing formation. Depth to top. Bottom. Total Depth of Well 3388 Feet

Show depth and thickness of all water, oil and gas formations.


OIL, GAS OR WATER RECORDS

CASING RECORD

Formation	Content	From	To	Size	Put In	Pulled Out
Florence Flint	HFW	1640	1670	15 $\frac{1}{2}$ "	202	202
Howard Limestone	HFW	2565	2585	12 $\frac{1}{2}$ "	521	521
Topeka	3 BW P.H.	2675	2685	10"	1672	1672
Lansing	S.S.Oil	3025		8"	2283	2283
" "	HFW	3115	3125	6"	2988	2988
Siliceous Lime	S.S.Oil	3360		5"	3175	3175
" "	HFW	3370	3388			

Describe in detail the manner in which the well was plugged, indicating where the mud fluid was placed and the method or methods used in introducing it into the hole. If cement or other plugs were used, state the character of same and depth placed, from. feet to feet for each plug set.

Used buckets to fill hole with heavy mud to 3345 (top of Siliceous lime), then drove wood limit plug there. Filled with mud to bottom of 5" casing, then un-seated and pulled 5" casing, continued filling hole with mud and pulling 6" 8" 10" and 12" casing, then bridged hole at 210' and cemented hole and pulled 15 $\frac{1}{2}$ " casing and filled to surface with mud.

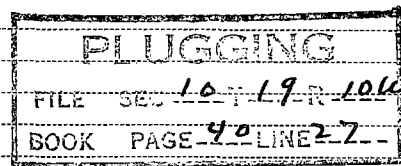

(If additional description is necessary use BACK of this sheet)

Correspondence regarding this well should be addressed to. Cusco Oil & Refining Company  
Address. Union National Bank Bldg. Wichita, Kansas.

STATE OF Kansas, COUNTY OF Sedgewick, SS.  
I, J. H. Siegel, Pres. Cusco Oil & Ref. Co. (employee of owner) - or (owner or operator) of the above-described well, being first duly sworn on oath, says: That I have knowledge of the facts, statements, and matters herein contained and the log of the above-described well as filed and that the same are true and correct. So help me God.

(Signature) J. H. Siegel

(Address)

SUBSCRIBED AND SWORN to before me this 29th day of October, 1936

My commission expires Nov 26, 1936

Charles Brewster  
Notary Public.

VERNON OIL & GAS COMPANY  
Wichita, Kansas.

Log of Well No. 1 - Located in NW corner of SW NW of  
Section 10-19-10 West, Rice County, Kansas.

Commenced November 15, 1935  
Completed March 30, 1936.

CASINO RECORD

202' 3"	151"
221'	122"
1578'	10"
2223'	8"
2339'	6"
2175'	5"

Shells	10	Sandy Line	1650
Sand	20	Line	1660
Shale	25	Red Rock	1670
Sand	30	Line	1685
Shale	35	Shale Shells	1755
Hard	127	Red Rock	1760
Shale	139	Line	1790
Sand	157	Red Rock	1795
Shale	175	Line	1810
Red Rock	185	Shale Shells	1850
Sand & Gravel	198	Red Rock & Shells	1900
Shale	205	Line	1950
Blue Mud	225	Shale	1955
Sand	235	Line	1970
Shale	245	Shale	1985
Red Rock	330	Red Rock	1990
Shale	350	Line	2020
Red Rock	420	Shale	2030
Shale	445	Line	2050
Red Rock	460	Shale Shells	2085
Line	465	Shale	2120
Red Rock	480	Line	2130
Red Mud	510	Shale	2150
Red Rock	520	Shale Shells	2160
Line	535	Red Rock	2190
Line	550	Shale	2200
Shale	558	Line	2210
Correction 558 equals 521 - Cable		Shale	2285
Red Rock	605	Line	2300
Line	610	Shale	2320
Red Rock	710	Line	2330
Line	720	Shale	2345
Red Rock	770	Line	2347
Shale & Shells	850	Shale Shells	2375
Red Rock	890	Line Shells	2400
Line	900	Line	2405
Shale	1000	Shale	2420
Line	1010	Line	2450
Salt	1235	Shale	2505
Shale Shells	1275	Line	2515
Shale	1285	Shale	2525
Red Rock	1290	Line	2545
Black Shale	1300	Shale	2560
Line	1305	Line	2600
Shale Shells	1320	HPW	2550-85
Line	1350	Shale	2605
Shale	1355	Line	2575
Line Shale	1380	S BW	2575-85
Shale Shells	1470	Sandy Line	2655
Broken Line	1500	Line	2710
Line	1505	Broken Line	2720
Red Rock	1520	Line	2775
Line	1640	Broken Line	2815


Boldt Log Continued  
Page #2.

Lime	2865	Small Show of Oil	3360
Shale	2870	Water (100' 1 Hr.)	3370
Lime	2880	Small Show of Oil	3025
1/2 BW	2790-2800	3BW	3095-3105
2BW	2800-2815	HFW	3115-3125
Shale Blue	2888		
Red Rock	2890		
Shale	2895		
Lime	2905		
Lime	2924		
Shale	2965		
Slate Blue	2985		
Shale	2990		
Lime	3001		
Broken Lime Shells	3005		
Lime Sandy	3030		
Lime	3115		
Sandy Lime	3125		
Sand	3134		
Lime	3157		
Red Rock	3160		
Lime	3215		
Lime Brown	3233		
Lime	3277		
Shale	3282		
Lime	3297		
Red Rock	3300		
Conglomerate	3333		
V. C. Shale & Chert	3338		
Chert	3345		
Lime	3388 - T. D.		

D & A.

PLUGGING  
FILE 10-19-10W  
BOOK PAGE 40 LINE 27

STATE OF KANSAS )  
                          ) SS  
COUNTY OF SEDGWICK)

W. R. Vickery, of lawful age, of Wichita, Kansas, being first duly sworn on, his oath, deposes and says that he is geologist for Vernon Oil & Gas Company, who drilled the well above referred to and that the above log and record is a true and correct copy of the log and record as kept by the drillers at said well.

*W. R. Vickery*

Subscribed and sworn to before me this 31st day of March, 1936.

My commission expires 3-9-39

*Leona A. Schmidt*  
Notary Public.