


Give All Information Completely
Make Required Affidavit
Mail or Deliver Report to:
Conservation Division
State Corporation Commission
212 North Market, Insurance Bldg.
Wichita, Kansas

WELL PLUGGING RECORD

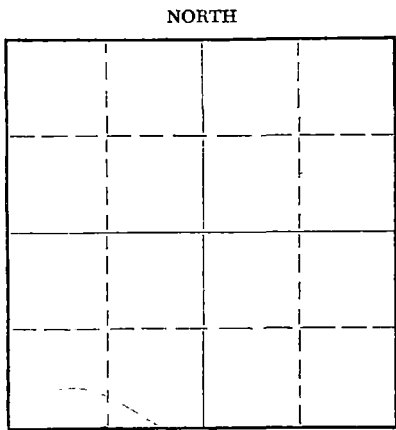

Locate well correctly on above Section Plat

Rice County. Sec. 9 Twp. 19 Rge. 10W (E) (W)
Location as "NE/CNW/SW" or footage from lines C SE SE
Lease Owner Arnell Company
Lease Name Schoenig Well No. 1
Office Address 533 Petroleum Building, Wichita, Kansas
Character of Well (completed as Oil, Gas or Dry Hole) Dry Hole
Date well completed 12/8/59 19
Application for plugging filed 12/8/59 19
Application for plugging approved 12/8/59 19
Plugging commenced 12/8/59 19
Plugging completed 12/8/59 19
Reason for abandonment of well or producing formation _____

If a producing well is abandoned, date of last production _____ 19
Was permission obtained from the Conservation Division or its agents before plugging was commenced? Yes

Name of Conservation Agent who supervised plugging of this well Gilbert J. Toman, Rice Co., Holyrood, Kansas
Producing formation _____ Depth to top _____ Bottom _____ Total Depth of Well 3357 Feet
Show depth and thickness of all water, oil and gas formations.

OIL, GAS OR WATER RECORDS

CASING RECORD

FORMATION	CONTENT	FROM	TO	SIZE	PUT IN	PULLED OUT
				8-5/8	258'	None

Describe in detail the manner in which the well was plugged, indicating where the mud fluid was placed and the method or methods used in introducing it into the hole. If cement or other plugs were used, state the character of same and depth placed, from _____ feet to _____ feet for each plug set.

Filled hole with mud from Total Depth, 3357, to 250';
Bridge with 1/4 sk hulls and 1 Halliburton plug, capped with
20 sx cement; Mud from 1st plug to 40'; Bridge set at 40'
capped with 10 sx cement; Filled to cellar with heavy rotary
mud.

STAT
MISSION
FEB 18 1960 2-18-1960
CONSERVATION DIVISION
Wichita, Kansas

(If additional description is necessary, use BACK of this sheet)

Name of Plugging Contractor National Drilling Company, Inc.
Address 535 Petroleum Building, Wichita, Kansas

STATE OF KANSAS, COUNTY OF SEDGWICK, ss.
Donald R. Douglass (employee of owner) or (~~owner~~) of the above-described well, being first duly sworn on oath, says: That I have knowledge of the facts, statements, and matters herein contained and the log of the above-described well as filed and that the same are true and correct. So help me God.

(Signature) Donald R. Douglass
533 Petroleum Building, Wichita, Kansas
(Address)

SUBSCRIBED AND SWORN TO before me this 16 day of February, 19 60

My commission expires 2/24/60 Betty Baker Notary Public.



DRILLERS LOG

CASING RECORD:
8-5/8"@258'

COMPANY: Artnell Company
533 Petroleum Bldg.
Wichita, Kansas

DESCRIPTION:
C SE SE 9-19-10W
Rice Co., Kansas

TOTAL DEPTH:

CONTRACTOR: Nat'l Drlg. Co.

3357 ft.

COMMENCED: 12/1/59

ELEVATION: 1766 R.B.

COMPLETED: 12/8/59

FORMATION	FROM	TO
Sand and Clay	0	160
Sand	160	218
Shale and Shells	218	258
Red Bed	258	460
Anhydrite	460	480
Shale and Shells	480	1580
Lime	1580	1780
Lime and Shale	1780	2025
Shale and Lime	2025	2340
Shale and Shells	2340	2470
Lime and Shale	2470	2690
Lime	2690	3357

I certify that this is a true and correct copy of the above log to the best of my knowledge.

NATIONAL DRILLING COMPANY, INC.

Howard A. Stoskopf
Howard A. Stoskopf, Vice President

Subscribed and sworn to before me this 5th day of January, 1960.

Betty Baker
Betty Baker, Notary Public

My Commission Expires: 2/24/60

RECEIVED
STATE CORPORATION COMMISSION
FEB 18 1960
CONSERVATION DIVISION
Wichita, Kansas