

STATE OF KANSAS
STATE CORPORATION COMMISSION

WELL PLUGGING RECORD

Give All Information Completely
Make Required Affidavit
Mail or Deliver Report to:
Conservation Division
State Corporation Commission
211 No. Broadway
Wichita, Kansas

Rice County, Sec. 6 Twp. 19 Rge. 10 (X) W (W)

Location as "NE/CNW/SW" or footage from lines NW NW SW

Lease Owner Nadel and Gussman

Lease Name Karber Well No. 1

Office Address 1714 First Natl Bldg. Tulsa 3, Oklahoma

Character of Well (completed as Oil, Gas or Dry Hole) Dry

Date well completed 2-6-1958

Application for plugging filed 2-6-1958

Application for plugging approved 2-6-1958


Plugging commenced 2-6-1958

Plugging completed 2-6-1958

Reason for abandonment of well or producing formation Dry

If a producing well is abandoned, date of last production 19

Was permission obtained from the Conservation Division or its agents before plugging was commenced? Yes

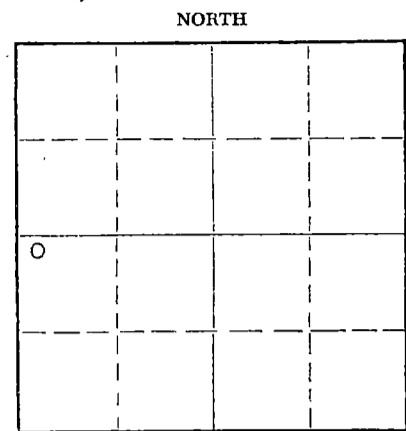

Locate well correctly on above Section Plat

Name of Conservation Agent who supervised plugging of this well Ruel Durkee

Producing formation Depth to top Bottom Total Depth of Well 3410 Feet

Show depth and thickness of all water, oil and gas formations.

OIL, GAS OR WATER RECORDS

CASING RECORD

FORMATION	CONTENT	FROM	TO	SIZE	PUT IN	PULLED OUT
				8-5/8"	214	0
RECEIVED STATE CORPORATION COMMISSION FEB 12 1958 2-12-1958						

Describe in detail the manner in which the well was plugged, indicating where the mud fluid was placed and the method or methods used in introducing it into the hole. If cement or other plugs were used, state the character of same and depth placed, from feet to feet for each plug set.

Filled hole with heavy mud from 3410' to 200' -
set plug with 15 sax cement

Set top plug at 20' with five sax cement

(If additional description is necessary, use BACK of this sheet)

Name of Plugging Contractor Reserve Drilling Company, Inc.

Address 625 Union Center, Wichita 2, Kansas

STATE OF KANSAS, COUNTY OF SEDGWICK, ss.
E. G. McNeil (employee of owner)

being first duly sworn on oath, says: That I have knowledge of the facts, statements, and matters herein contained and the log of the above-described well as filed and that the same are true and correct. So help me God.

(Signature) E. G. McNeil

Wichita, Kansas (Address)

SUBSCRIBED AND SWORN TO before me this 11 day of February 1958

My commission expires Nov. 3, 1960

Notary Public.

PLUGGING
FILE SEC 6 T19 R104
BOOK PAGE 81 LINE 26

WELL LOG

Nadel and Gussman

Karber Well No. 1

NW NW SW 6-19-10W
Rice County, Kansas

Comm: 1-27-58
Comp: 2-6-58

Casing: 8-5/8" 214' w/125 sax

<u>Formations</u>	<u>Depth</u>	<u>Geological Tops</u>	
Sand, shale and shells	215	Heebner Shale	2900'
Shale and red bed	540	Brown Lime	3020'
Anhydrite	562	Lansing-Kansas City	3039'
Red bed, shale and shells	875	Conglomerate	3350'
Shale and shells	1355	Arbuckle	3354'
Shale and lime	1795		
Lime	1885		
Shale and lime	2800		
Lime	2860		
Lime and shale	3110		
Lime	3354		
Lime and shale	3367		
Arbuckle	3377		
Lime	3410		

RECORDED
ST. JOHN COUNTY, KANSAS
FEB 12 1958
REGISTRATION DIVISION
Wichita, Kansas

STATE OF KANSAS)
COUNTY OF SEDGWICK)

SS:

E. G. McNeil, of lawful age, states that the above formations and depths are correct to his best knowledge.

E. G. McNeil

Subscribed and sworn to before me this 11th day of February, 1958.

My commission expires Nov. 3, 1960

Robert P. [Signature]
Notary Public

PLUGGING
FILE SEC. 6 T. 19 R. 10W
BOOK PAGE 81 LINE 26