

15-145-00361-0000

STATE OF KANSAS
STATE CORPORATION COMMISSION


WELL PLUGGING RECORD

Give All Information Completely
Make Required Affidavit
Mail or Deliver Report to:
Conservation Division
State Corporation Commission
800 Bittling Building
Wichita, Kansas

Pawnee County, Sec. 11 Twp. 23 Rge. 17W (E) (W)

Location as "NE/CNW/SW" or footage from lines NW NW NE
Lease Owner Leben Drilling Company
Lease Name Magnolia Ellis Well No. 1
Office Address 505 Orpheum Bldg, Wichita, Kansas
Character of Well (completed as Oil, Gas or Dry Hole) Dry Hole
Date well completed June 26, 1955
Application for plugging filed 6-26 19 55
Application for plugging approved 6-26 19 55
Plugging commenced 6-26 19 55
Plugging completed 6-26- 19 55
Reason for abandonment of well or producing formation Dry Hole

NORTH

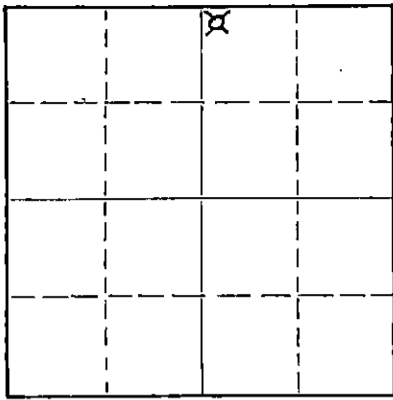

Locate well correctly on above
Section Plat

If a producing well is abandoned, date of last production _____ 19____
Was permission obtained from the Conservation Division or its agents before plugging was commenced? Yes

Name of Conservation Agent who supervised plugging of this well Warren Homer
Producing formation _____ Depth to top _____ Bottom _____ Total Depth of Well 4240 Feet
Show depth and thickness of all water, oil and gas formations.

OIL, GAS OR WATER RECORDS

CASING RECORD

FORMATION	CONTENT	FROM	TO	SIZE	PUT IN	PULLED OUT
				8 5/8"	197'	

Describe in detail the manner in which the well was plugged, indicating where the mud fluid was placed and the method or methods used in introducing it into the hole. If cement or other plugs were used, state the character of same and depth placed, from _____ feet to _____ feet for each plug set.

Plugged hole with 85' sks cement

(If additional description is necessary, use BACK of this sheet)
Name of Plugging Contractor Leben Drilling Company
Address 505 Orpheum Bldg, Wichita 2, Kansas

STATE OF KANSAS, COUNTY OF SEDGWICK, ss.
Norma D. Sisson (employee of owner) or (~~owner or operator~~) of the above-described well, being first duly sworn on oath, says: That I have knowledge of the facts, statements, and matters herein contained and the log of the above-described well as filed and that the same are true and correct. So help me God.

(Signature) Norma D. Sisson
Wichita 2, Kansas
(Address)

SUBSCRIBED AND SWORN to before me this 30th day of June, 1955

My commission expires April 20, 1959

STATE COMMISSIONER
Notary Public.

PLUGGING
FILE SEC 11 T 23 R 17W
BOOK 120 LINE 12

CONSERVATION DIVISION
Wichita, Kansas
7-5-1955

CONTRACTOR'S WELL LOG

15-145-00361-0000

COMPANY:
CONTRACTOR:
FARM:
LOCATION:

COMMENCED:
COMPLETED:

Leben Drilling Company
Leben Drilling Company
Magnolia Ellis #1
NW NW NE Sec. 11-23-17W,
Pawnee County, Kansas
June 13, 1955
June 26, 1955

0	203	Surface sand
203	283	Shale
283	577	Blue shale
577	652	Sand
652	1080	Shale, red bed
1080	1107	Anhydrite
1107	1235	Shale, red bed
1235	1518	Shale, lime
1518	2065	Shale
2065	2092	Shale, lime
2092	2468	Lime, shale
2468	2555	Shale, lime
2555	2661	Lime shale
2661	2875	Shale, lime
2875	2974	Lime, shale
2974	3414	Shale, lime
3414	3591	Lime, shale
3591	3790	Shale, lime
3790	4140	Lime, shale
4140	4200	Shale, chert
4200	4240	Viola Rotary Total Depth Dry and Abandoned

Set 194' of 8 5/8" surface casing.

I, Norma D. Sisson, do hereby certify that the above and foregoing is a true and correct copy of the log of the Magnolia Ellis #1, NW NW NE Sec. 11-23-17W, Pawnee County, Kansas, as reflected by the files of the Leben Drilling Company.

LEBEN DRILLING COMPANY

BY:

Norma D. Sisson

STATE OF KANSAS)
COUNTY OF SEDGWICK) SS

Subscribed and sworn to before me, a Notary Public, in and for Sedgwick County, Kansas, this 29th day of June 1955.

Norma D. Sisson

Notary Public

My commission expires April 20, 1959

PLUGGING
SEC 11 T 22 R 17 W
BOOK PAGE 170 LINE 12

RECEIVED
STATE CORPORATION
JUL 5 - 1955
CONSERVATION DIVISION
Wichita, Kansas