


15-145-30170-0001

STATE OF KANSAS  
STATE CORPORATION COMMISSION

WELL PLUGGING RECORD

Give All Information Completely  
Make Required Affidavit  
Mail or Deliver Report to:  
Conservation Division  
State Corporation Commission  
300 Bitting Building  
Wichita, Kansas

Paynee \_\_\_\_\_ County, Sec. 13 Twp. 23S Rge. (E) 17 (W)  
Location as "NE/CNW/SW" or footage from lines SE SE NE  
Lease Owner Colorado Oil and Gas Corporation  
Lease Name Paramore Well No. 1  
Office Address Box 1030, Wichita, Kansas  
Character of Well (completed as Oil, Gas or Dry Hole) Dry Hole  
Date well completed March 20 1956  
Application for plugging filed March 20 1956  
Application for plugging approved March 20 1956  
Plugging commenced March 20 1956  
Plugging completed March 20 1956  
Reason for abandonment of well or producing formation Dry

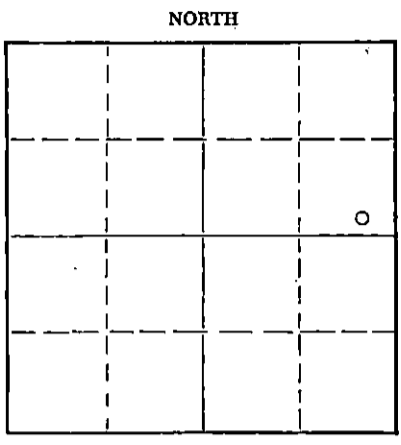

Locate well correctly on above Section Plat

If a producing well is abandoned, date of last production \_\_\_\_\_ 19\_\_\_\_  
Was permission obtained from the Conservation Division or its agents before plugging was commenced? yes

Name of Conservation Agent who supervised plugging of this well R. M. Brundage  
Producing formation \_\_\_\_\_ Depth to top \_\_\_\_\_ Bottom \_\_\_\_\_ Total Depth of Well 4452 Feet  
Show depth and thickness of all water, oil and gas formations.

OIL, GAS OR WATER RECORDS

CASING RECORD

FORMATION	CONTENT	FROM	TO	SIZE	PUT IN	PULLED OUT
				8 5/8"	313 ft	None

Describe in detail the manner in which the well was plugged, indicating where the mud fluid was placed and the method or methods used in introducing it into the hole. If cement or other plugs were used, state the character of same and depth placed, from \_\_\_\_\_ feet to \_\_\_\_\_ feet for each plug set.

Plug #1 set @ 300 ft. w/25 sks. cmt.  
Plug #2 set @ 75 ft. w/25 skx. cmt.  
Cement to surface

(If additional description is necessary, use BACK of this sheet)

Name of Plugging Contractor E. F. Wakefield  
Address 307 Union National Bank Building, Wichita, Kansas

STATE OF Kansas, COUNTY OF Sedgwick, ss.  
C. R. Dardenne (employee of owner) or (owner or operator) of the above-described well, being first duly sworn on oath, says: That I have knowledge of the facts, statements, and matters herein contained and the log of the above-described well as filed and that the same are true and correct. So help me God.

(Signature) C. R. Dardenne  
C. R. Dardenne

Box 1030, Wichita, (Address) Kansas

SUBSCRIBED AND SWORN TO before me this 28th day of March, 1956

My commission expires August 24, 1956

H. A. Bilson  
H. A. Bilson Notary Public.

**PLUGGING**  
FILE SEC 13 T 23 R 17W  
BOOK PAGE 42 LINE 14

RECEIVED  
STATE CORPORATION COMMISSION  
MAR 29 1956 3-29-1956

15-145-30770-0001

PARAMORE #1  
OWNER: COLORADO OIL & GAS CORP.  
CONTRACTOR: EARL F. WAKEFIELD  
COMM: 3/5/56 COMP: 3/20/56

SE SE NE  
13 23S 17W  
PAWNEE COUNTY, KANSAS  
CASING: 8 5/8" set @ 313 ft.

Surface Clay	30
Sand	100
Shale & Shells	530
Red Bed	560
Sand	610
Shale & Shells	1100
Anhydrite	1135
Shale & Shells	1330
Lime	1335
Shale & Shells	1430
Shale	1490
Shale & Salt	1750
Shale & Shells	2030
Lime	2150
Shale & Lime	2345
Lime	2525
Lime & Shale	2780
Lime	2815
Shale	3070
Lime & Shale	3348
Shale	3445
Lime & Shale	3600
Lime	3870
Shale & Lime	3964
Lime	4126
Conglomerate	4135
Lime	4220
Chert Shale & Sand	4240
Lime	4350
Shale	4375
Lime	4452
Rotary Total Depth	4452

STATE OF KANSAS )  
                  ) SS  
COUNTY OF SEDGWICK)

I hereby agree and certify that the above is a true and correct copy of the log on the Paramore #1 well located SE SE NE, 13-23S-17W, Pawnee County, Kansas.

*F. S. Barker*

F. S. Barker

Sworn and subscribed before me this 27<sup>th</sup> day of March, 1956.

*[Signature]*

Notary Public

My commission expires July 26, 1958.

**PLUGGING**  
WELL NO. 13-23S-17W  
BOOK PAGE 47 LINE 17