


STATE OF KANSAS  
STATE CORPORATION COMMISSION

Give All Information Completely  
Make Required Affidavit  
Mail or Deliver Report to:  
Conservation Division  
State Corporation Commission  
212 No. Market  
Wichita, Kansas

WELL PLUGGING RECORD

NORTH

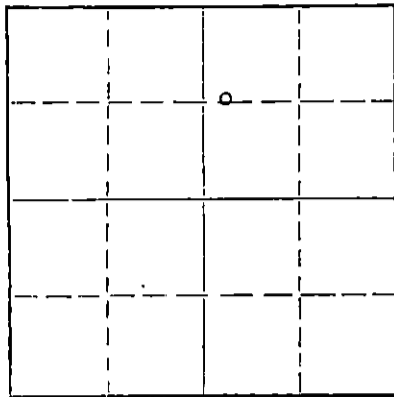

Locate well correctly on above Section Plat

Pawnee County, Sec. 16 Twp. 23 Rge. (E) 17 (W)  
Location as "NE/CNW/SW" or footage from lines W/2 W/2 NE/4  
Lease Owner Colorado Oil Company  
Lease Name Fertig "A" Well No. 7  
Office Address 915 Union Natl. Bldg., Wichita, Kansas 67202  
Character of Well (completed as Oil, Gas or Dry Hole) Oil  
Date well completed March 6 19 58  
Application for plugging filed October 27 19 69  
Application for plugging approved October 28 19 69  
Plugging commenced November 18 19 69  
Plugging completed December 15 19 69  
Reason for abandonment of well or producing formation Depleted

If a producing well is abandoned, date of last production September 19 69  
Was permission obtained from the Conservation Division or its agents before plugging was commenced? Yes

Name of Conservation Agent who supervised plugging of this well Massey  
Producing formation Conglomerate Chert Depth to top 4250' Bottom \_\_\_\_\_ Total Depth of Well 4310' Feet  
Show depth and thickness of all water, oil and gas formations.

OIL, GAS OR WATER RECORDS

CASING RECORD

FORMATION	CONTENT	FROM	TO	SIZE	PUT IN	PULLED OUT
				8-5/8"	276'	None
				5-1/2"	4308'	2995'

Describe in detail the manner in which the well was plugged, indicating where the mud fluid was placed and the method or methods used in introducing it into the hole. If cement or other plugs were used, state the character of same and depth placed, from \_\_\_\_\_ feet to \_\_\_\_\_ feet for each plug set.

Checked bottom, ran sand to 4200' and dumped 5 sacks of cement.  
Loaded hole, shot pipe at 3200', 3107', 3006', worked pipe loose  
and pulled 92 joints. Halliburton pumped 5 sacks hulls, 20 sacks  
gel and 100 sacks of cement to plug well.

PLUGGING COMPLETE.

RECEIVED 12-24-1969  
STATE CORPORATION COMMISSION  
DEC 24 1969  
CONSERVATION DIVISION  
Wichita, Kansas

(If additional description is necessary, use BACK of this sheet)

Name of Plugging Contractor Knight Casing Pulling Co., Inc.  
Address Chase, Kansas

STATE OF Kansas, COUNTY OF Sedgwick, ss.  
Bill K. Henrichs (employee of owner) or (owner or operator) of the above-described well, being first duly sworn on oath, says: That I have knowledge of the facts, statements, and matters herein contained and the log of the above-described well as filed and that the same are true and correct. So help me God.

(Signature) Bill K. Henrichs  
915 Union National Bldg., Wichita, Kansas  
(Address)

SUBSCRIBED AND SWORN TO before me this 23rd day of December, 19 69

My commission expires Feb. 19, 1973

Betty J. McElwain  
Betty J. McElwain Notary Public.

15-145-01193-0000

DRILLERS' LOG

Well Owner: Peel-Hardman Oil Operators  
Farm Name: Fertig Well No. 7  
Commenced: 2/21/58  
Completed: 3/6/58  
Total Depth: 4310'  
Casing: 8 5/8" @ 276' cemented  
5 1/2" @ 4308' cemented

1320' E of N line,  
330' E of W line  
Sec. 16-23E-17N  
Pawnee County, Kans.

Elevation:

Production:

Contractor: Glenn W. Peel

Figures below indicate bottoms of formations:

Sand	0 -	150
Sand and shale		250
Shale		420
Shale and sand		500
Red bed		610
Sand		750
Red bed		1145
Anhydrite		1175
Shale and red bed		1210
Shale and shells		1600
Shale		2000
Lime		2460
Lime and shale		2610
Lime		2735
Lime and shale		3250
Lime		4150
Lime and shale		4200
Lime		4310
Total Depth		4310

This is to certify that the above information is to the best of our knowledge, true and correct.

GLENN W. PEEL

BY *Glenn W. Peel*

SUBSCRIBED AND SWORN to before me this 7th day of March, 1958

My commission expires: April 27, 1960

*Keith Brant*  
Notary Public

RECEIVED  
STATE CORPORATION COMMISSION  
OCT 28 1969  
CONSERVATION DIVISION  
Wichita, Kansas