

15-145-01192-0000


STATE OF KANSAS
STATE CORPORATION COMMISSION

Form CP-4

Give All Information Completely
Make Required Affidavit
Mail or Deliver Report to:
Conservation Division
State Corporation Commission
212 No. Market
Wichita, Kansas

WELL PLUGGING RECORD

_____ Pawnee _____ County. Sec. 16 Twp. 23 Rge. _____ (E) 17 (W)
Location as "NE/CNW/SW" or footage from lines _____ C NE/4
Lease Owner Colorado Oil Company
Lease Name Fertig "A" Well No. 6
Office Address 915 Union National Bldg., Wichita, Kansas 67202
Character of Well (completed as Oil, Gas or Dry Hole) Oil
Date well completed _____ September 13 19 55
Application for plugging filed _____ October 27 19 69
Application for plugging approved _____ October 28 19 69
Plugging commenced _____ November 22 19 69
Plugging completed _____ December 15 19 69
Reason for abandonment of well or producing formation _____ Depleted

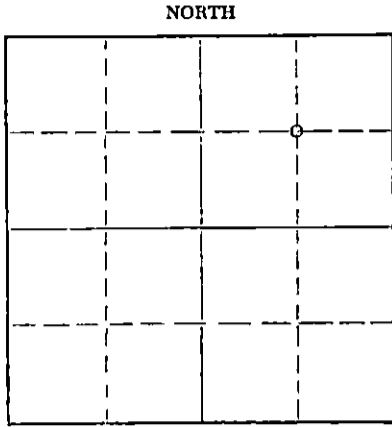

Locate well correctly on above Section Plat

If a producing well is abandoned, date of last production _____ September _____ 19 67
Was permission obtained from the Conservation Division or its agents before plugging was commenced? _____ Yes

Name of Conservation Agent who supervised plugging of this well _____ Leo Massey
Producing formation Conglomerate Chert Depth to top 4258 Bottom _____ Total Depth of Well 4381 Feet
Show depth and thickness of all water, oil and gas formations. 4281

OIL, GAS OR WATER RECORDS

CASING RECORD

FORMATION	CONTENT	FROM	TO	SIZE	PUT IN	PULLED OUT
				8-5/8"	210'	None
				5-1/2"	4271'	2622'

Describe in detail the manner in which the well was plugged, indicating where the mud fluid was placed and the method or methods used in introducing it into the hole. If cement or other plugs were used, state the character of same and depth placed, from _____ feet to _____ feet for each plug set.

Checked bottom, ran sand to 4200' and dumped 5 sacks of cement.
Loaded hole, shot pipe at 3224', 3126', 3129', 2995', 2808',
2705', 2616', worked pipe loose and pulled 81 joints. Halliburton
pumped 5 sacks hulls, 20 sacks gel and 100 sacks of cement to
plug well.

PLUGGING COMPLETE.

12-24-1969
RECEIVED
STATE CORPORATION COMMISSION
DEC 24 1969
CONSERVATION DIVISION
Wichita, Kansas

(If additional description is necessary, use BACK of this sheet)

Name of Plugging Contractor _____ Knight Casing Pulling Co., Inc.
Address _____ Chase, Kansas

STATE OF Kansas, COUNTY OF Sedgwick, ss.
Bill K. Henrichs (employee or operator) of the above-described well, being first duly sworn on oath, says: That I have knowledge of the facts, statements, and matters herein contained and the log of the above-described well as filed and that the same are true and correct. So help me God.

(Signature) Bill K. Henrichs
915 Union National Bldg., Wichita, Kansas
(Address)

Subscribed and sworn to before me this 23rd day of December, 19 69

My commission expires Feb. 19, 1973

Betty J. McElwain
Betty J. McElwain Notary Public.

DRILLERS' LOG

Company: Peel-Hardman Oil Producers

Farm Name: Fertig Well No. 6

Total Depth: 4281'

Comm: 9-1-55 Comp: 9-13-55

Contractor: Glenn W. Peel

Casing: 8 5/8" 210' cem.
5 1/2" 4271' cem.

C NE/4
Sec. 16, Twp. 23S, Rge. 17 W,

County: Pawnee,
Kansas

Elevation:

Production:

Figures below indicate bottoms of formations:

Surface clay	0 -	20
Sand and gravel		135
Shale		260
Shale, shells, red bed		910
Shale, shells		1146
Anhydrite		1178
Shale shells		1350
Shale		1985
Shale and shells		2165
Shale and lime		2640
Lime		2740
Shale and shells		2890
Shale and lime		2985
Shale		3125
Shale and lime		3300
Lime		3725
Lime and shale		3810
Lime		4281
Total Depth		4281

RECEIVED
STATE CORPORATION COMMISSION
OCT 28 1969
CONSERVATION DIVISION
Wichita, Kansas

This is to certify that the above information is to the best of our knowledge, true and correct.

GLENN W. PEEL

BY: Glenn W. Peel

SUBSCRIBED AND SWORN to before me this 21st day of September, 1955.

My commission expires: June 4, 1959

Marian M. Herbst
Notary Public