


STATE OF KANSAS  
STATE CORPORATION COMMISSION

Give All Information Completely  
Make Required Affidavit  
Mail or Deliver Report to:  
Conservation Division  
State Corporation Commission  
212 No. Market  
Wichita, Kansas

WELL PLUGGING RECORD

Pawnee County, Sec. 16 Twp. 23 Rge. (E) 17 (W)  
Location as "NE/CNW/SW" or footage from lines 1320' SNL, 440' WEL  
Lease Owner Colorado Oil Company  
Lease Name Fertig "A" Well No. 4  
Office Address 915 Union National Bldg., Wichita, Kansas 67202  
Character of Well (completed as Oil, Gas or Dry Hole) Oil  
Date well completed April 22 19 55  
Application for plugging filed October 27 19 69  
Application for plugging approved October 28 19 69  
Plugging commenced November 28 19 69  
Plugging completed December 15 19 69  
Reason for abandonment of well or producing formation Depleted

NORTH

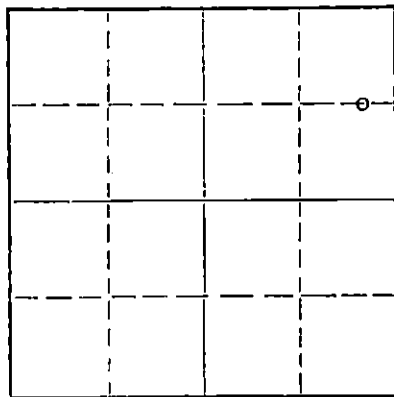

Locate well correctly on above Section Plat

If a producing well is abandoned, date of last production September 19 69  
Was permission obtained from the Conservation Division or its agents before plugging was commenced? Yes

Name of Conservation Agent who supervised plugging of this well Massey  
Producing formation Conglomerate Chert Depth to top 4236 Bottom Total Depth of Well 4285 Feet  
Show depth and thickness of all water, oil and gas formations.

OIL, GAS OR WATER RECORDS

CASING RECORD

FORMATION	CONTENT	FROM	TO	SIZE	PUT IN	PULLED OUT
				8-5/8"	210'	None
				5-1/2"	4284'	3028'

Describe in detail the manner in which the well was plugged, indicating where the mud fluid was placed and the method or methods used in introducing it into the hole. If cement or other plugs were used, state the character of same and depth placed, from feet to feet for each plug set.

Checked bottom, ran sand to 4200' and ran 5 sacks of cement.  
Loaded hole, shot pipe at 3230', 3137', 3040', worked pipe loose and pulled 84 joints. Halliburton pumped 5 sacks of hulls, 20 sacks of gel and 100 sacks of cement to plug well.

PLUGGING COMPLETE.

12-24-1969  
RECEIVED  
STATE CORPORATION COMMISSION  
DEC 24 1969  
CONSERVATION DIVISION  
Wichita, Kansas

(If additional description is necessary, use BACK of this sheet)  
Name of Plugging Contractor Knight Casing Pulling Co., Inc.  
Address Chase, Kansas

STATE OF Kansas, COUNTY OF Sedgwick, ss.  
Bill K. Henrichs (employee of owner) or (owner or operator) of the above-described well, being first duly sworn on oath, says: That I have knowledge of the facts, statements, and matters herein contained and the log of the above-described well as filed and that the same are true and correct. So help me God.

(Signature) Bill K. Henrichs  
915 Union Natl. Bldg., Wichita, Kansas 67202  
(Address)

SUBSCRIBED AND SWORN to before me this 23rd day of December, 19 69

My commission expires Feb. 19, 1973  
Betty J. McElwain Notary Public.

DRILLERS' LOG

Company: Peel-Hardman Oil Producers

440' from EL; 1320' from NL & SL/NE/4

Farm Name: Fertig Well No. 4

Sec. 16, Twp. 23S, Rge. 17W

Total Depth: 4235'

County: Pawnee, Kansas

Case: 4-9-55 Comp: 4-22-55  
Contractor: Glenn W. Peel

Elevation:

Casing: 8 5/8" 210' con.  
5 1/2" 4235' con.

Production:

Figures below indicate bottoms of formations:

Sand and shale	0 -	210
Shale		360
Shale, Red bed and shells		1035
Shells, Anhydrite and shale		1325
Shale and shells		2020
Shale and lime streaks		2150
Lime and shale		2420
Lime		2510
Lime and shale		2900
Shale and lime streaks		3225
Shale and lime		3325
Lime		4261
Lime Conglomerate		4235
Total Depth		4235

RECEIVED  
STATE CORPORATION COMMISSION  
OCT 28 1969  
CONSERVATION DIVISION  
Wichita, Kansas

This is to certify that the above information is to the best of our knowledge, true and correct.

GLENN W. PEEL

BY: *Glenn W. Peel*

SUBSCRIBED AND SWORN to before me this 25<sup>th</sup> day of April, 1955

My commission expires: June 4, 1955

*Marion M. Herbert*  
Notary Public