


Give All Information Completely
Make Required Affidavit
Mail or Deliver Report to:
Conservation Division
State Corporation Commission
212 No. Market
Wichita, Kansas

WELL PLUGGING RECORD

Pawnee County, Sec. 16 Twp. 23 Rge. (E) 17 (W)

Location as "NE/CNW%SW%" or footage from lines 440' SNL, 1320' WEL NE/4
Lease Owner Colorado Oil Company
Lease Name Fertig "A" Well No. 3
Office Address 915 Union National Bldg., Wichita, Kansas 67202
Character of Well (completed as Oil, Gas or Dry Hole) Oil
Date well completed April 8 19 55
Application for plugging filed October 27 19 69
Application for plugging approved October 28 19 69
Plugging commenced December 10 19 69
Plugging completed December 15 19 69
Reason for abandonment of well or producing formation Depleted

NORTH

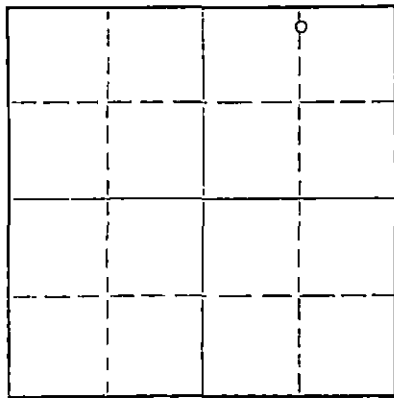

Locate well correctly on above
Section Plat

If a producing well is abandoned, date of last production September 19 69
Was permission obtained from the Conservation Division or its agents before plugging was commenced? Yes

Name of Conservation Agent who supervised plugging of this well Massey
Producing formation Conglomerate Chert Depth to top 4244 Bottom _____ Total Depth of Well 4276 Feet
Show depth and thickness of all water, oil and gas formations.

OIL, GAS OR WATER RECORDS

CASING RECORD

FORMATION	CONTENT	FROM	TO	SIZE	PUT IN	PULLED OUT
				8-5/8"	224'	None
				5-1/2"	4264'	3010'

Describe in detail the manner in which the well was plugged, indicating where the mud fluid was placed and the method or methods used in introducing it into the hole. If cement or other plugs were used, state the character of same and depth placed, from _____ feet to _____ feet for each plug set.

Checked bottom, ran sand to 4200', dumped 5 sacks of cement.
Loaded hole, shot pipe at 3185', checked hole, fluid went away,
set plug at 3100', loaded hole, shot pipe at 3025', worked pipe
loose and pulled 94 joints. Halliburton pumped 5 sacks hulls, 20
sacks gel and 100 sacks of cement to plug well.

PLUGGING COMPLETE.

RECEIVED
STATE CORPORATION COMMISSION
DEC 24 1969
CONSERVATION DIVISION
Wichita, Kansas
12-24-1969

(If additional description is necessary, use BACK of this sheet)

Name of Plugging Contractor Knight Casing Pulling Co., Inc.
Address Chase, Kansas

STATE OF Kansas, COUNTY OF Sedgwick, ss.
Bill K. Henrichs (employee of owner) or (owner or operator) of the above-described well, being first duly sworn on oath, says: That I have knowledge of the facts, statements, and matters herein contained and the log of the above-described well as filed and that the same are true and correct. So help me God.

(Signature) Bill K. Henrichs
915 Union Natl. Bldg., Wichita, Kansas 67202
(Address)

SUBSCRIBED AND SWORN to before me this 23rd day of December, 1969

My commission expires Feb. 19, 1973

Betty J. McElwain
Betty J. McElwain Notary Public.

DRILLERS' LOG

Company: Peol-Hardman Oil Producers

440' from the EL; 1320' from the EL; NE/4
Sec. 16, Twp. 23S, Rge. 17W,

Form Name: Fertig Well No. 3

County: Pawnee,
Kansas

Total Depth: 4276'

Comm: 3-27-55 Comp: 4-8-55

Elevation:

Contractor: Glenn W. Peol

Production:

Casing: 3 5/8" 224' cem.
5 1/2" 4264' cem.

Figures below indicate bottoms of formations:

Clay, sand and shale	0 -	124
Shale		285
Shale and red bed		1153
Anhydrite		1360
Shale		1975
Shale and lime		2119
Lime		2665
Lime and shale		2825
Shale		3060
Shale and lime streaks		3170
Lime and shale		3400
Lime		3565
Lime and shale		3615
Lime		4276
Total Depth		4276

RECEIVED
STATE CORPORATION COMMISSION
OCT. 28 1969
CONSERVATION DIVISION
Wichita, Kansas

This is to certify that the above information is to the best of our knowledge, true and correct.

GLENN W. PEOL

BY: *Glenn W. Peol*

SUBSCRIBED AND SWORN to before me this 11th day of April, 1955

My commission expires: June 4, 1955

Marian M. Herbert
Notary Public