


STATE OF KANSAS  
STATE CORPORATION COMMISSION

WELL PLUGGING RECORD

Give All Information Completely  
Make Required Affidavit  
Mail or Deliver Report to:  
Conservation Division  
State Corporation Commission  
212 No. Market  
Wichita, Kansas 67202

NORTH

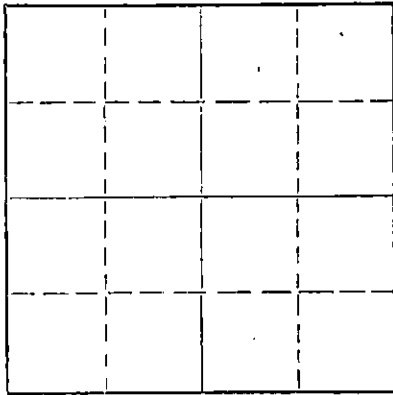

Locate well correctly on above  
Section Plat

Pawnee County, Sec. 16 Twp. 23 Rge. 17 (E) (W)  
Location as "NE/CNW/SW" or footage from lines SE NW NW  
Lease Owner Maurice L. Brown  
Lease Name Fergus A#5 Well No.  
Office Address Kansas City, Missouri 64141  
Character of Well (completed as Oil, Gas or Dry Hole)  
Date well completed 19  
Application for plugging filed 19  
Application for plugging approved 19  
Plugging commenced 9/14/70 19  
Plugging completed 9/19/70 19  
Reason for abandonment of well or producing formation depleted.

If a producing well is abandoned, date of last production 19  
Was permission obtained from the Conservation Division or its agents before plugging was commenced? yes

Name of Conservation Agent who supervised plugging of this well Massey  
Producing formation Depth to top Bottom Total Depth of Well 4347' Feet  
Show depth and thickness of all water, oil and gas formations.

OIL, GAS OR WATER RECORDS

CASING RECORD

FORMATION	CONTENT	FROM	TO	SIZE	PUT IN	PULLED OUT
				8-5/8	224	none
				5 1/2"	4345'	3310'

Describe in detail the manner in which the well was plugged, indicating where the mud fluid was placed and the method or methods used in introducing it into the hole. If cement or other plugs were used, state the character of same and depth placed, from feet to feet for each plug set.

Checked bottom, ran sand to 4200', dumped 5 sacks of cement.  
Loaded hole, shot pipe at 3423', Allied pumped 40 barrels oil,  
chased plug to 3300', worked pipe, shot pipe at 3333', worked pipe loose  
and pulled 103 joints. Pumped 3 hulls, 20 gal and 100 cement to plug well.

PLUGGING COMPLETE.


RECEIVED  
STATE CORPORATION COMMISSION  
SEP 28 1970  
CONSERVATION DIVISION  
Wichita, Kansas  
9-28-1970

(If additional description is necessary, use BACK of this sheet)  
Name of Plugging Contractor KNIGHT CASING PULLING CO., INC.  
Address CHASE, KANSAS

STATE OF KANSAS, COUNTY OF RICE, ss.  
NOEL J. KNIGHT (employee of owner) or (owner or operator) of the above-described well, being first duly sworn on oath, says: That I have knowledge of the facts, statements, and matters herein contained and the log of the above-described well as filed and that the same are true and correct. So help me God.

(Signature) Noel Knight  
CHASE, KANSAS  
(Address)

Subscribed and sworn to before me this 21st day of September 19 70

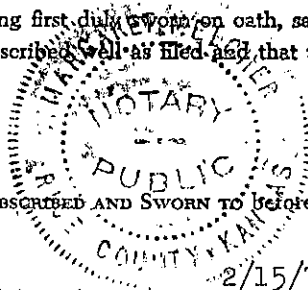

Margaret Milnes  
Notary Public.

15-145-00865-0000  
 RECEIVED  
 STATE CORPORATION COMMISSION  
 AUG 19 1970  
 CONSERVATION DIVISION  
 Wichita, Kansas

DRILLER'S LOG

COMPANY: Westpan Hydrocarbon Company      LOCATION: SE NW NW  
 CONTRACTOR: Hilton Drilling Company, Inc.      Sec. 16-23S-17W  
    Pawnee County, Kansas  
 FARM NAME: Fergus "A" No. 5      ELEVATION: 2102 D.F.  
 COMMENCED: November 21, 1955      Casing Used: 8-5/8" @ 224' w/200 sxs.  
    5-1/2" @ 4345' w/150 sxs.  
 COMPLETED: December 3, 1955

Sand & Clay	30
Sand	60
Shale	90
Shale and Sand	178
Shale	290
Shale and Shells	380
Red Bed and Sand	600
Sand	670
Red Bed	1125
Anhydrote	1155
Shale and Shells	1950
Shale and Lime	2175
Lime	2415
Sand and Lime	2560
Lime	2670
Shale and Lime	3000
Shale and Brown Lime	3150
Lime	3710
Shale and Lime	3764
Lime	4200
Shale, Lime and Chert	4241
Lime and Chert	4265
Shale, Sand, Lime & Chert	4347
Total Depth	4347

STATE OF KANSAS    )  
                                   ) SS.  
 COUNTY OF BARTON )

I, the undersigned, being duly sworn on oath, state that the above statement and log are true and a correct record and log of the well drilled at the location above described.

HILTON DRILLING COMPANY, INC.

*[Handwritten Signature]*  
 \_\_\_\_\_

Subscribed and sworn to before me this 9th day of December, 1955.

*[Handwritten Signature]*  
 \_\_\_\_\_

Notary Public

MILDRED HORBIE  
 MY COMMISSION EXPIRES MARCH 6, 1958