


STATE OF KANSAS
STATE CORPORATION COMMISSION

WELL PLUGGING RECORD

Give All Information Completely
Make Required Affidavit
Mail or Deliver Report to:
Conservation Division
State Corporation Commission
211 No. Broadway
Wichita, Kansas

NORTH

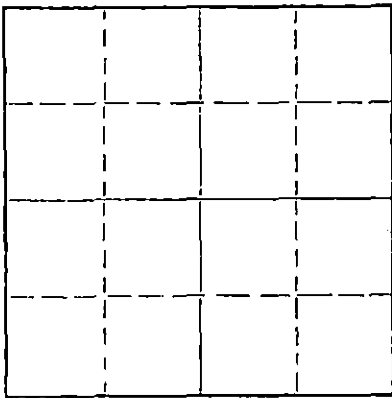

Locate well correctly on above
Section Plat

Barton County. Sec. 24 Twp. 20 Rge. 12 (E) W (W)
Location as "NE/CNWxSWx" or footage from lines NW SW NW
Lease Owner Glickman Oil Co.
Lease Name Scheufler Well No. 4
Office Address Wichita, Kansas
Character of Well (completed as Oil, Gas or Dry Hole) _____
Date well completed _____ 19____
Application for plugging filed Yes 19____
Application for plugging approved January 25 19 65
Plugging commenced Feb. 18 1965
Plugging completed Feb. 24 1965
Reason for abandonment of well or producing formation _____

If a producing well is abandoned, date of last production _____ 19____
Was permission obtained from the Conservation Division or its agents before plugging was commenced? Yes

Name of Conservation Agent who supervised plugging of this well Truan
Producing formation _____ Depth to top _____ Bottom _____ Total Depth of Well 3372 Feet
Show depth and thickness of all water, oil and gas formations.

OIL, GAS OR WATER RECORDS

CASING RECORD

FORMATION	CONTENT	FROM	TO	SIZE	PUT IN	PULLED OUT
				6"		1685.65 ft.

Describe in detail the manner in which the well was plugged, indicating where the mud fluid was placed and the method or methods used in introducing it into the hole. If cement or other plugs were used, state the character of same and depth placed, from 3372 feet to surface feet for each plug set.

Sanded hole to 2950' dump 5 sacks of cement on bottom.
Set rock bridge at 230' dump 5 sacks of mud & 35 sacks of
cement on bridge.
Well completed.

RECEIVED 3-19-1965
STATE CORPORATION COMMISSION
MAR 19 1965
CONSERVATION DIVISION
Wichita, Kansas

(If additional description is necessary, use BACK of this sheet)

Name of Plugging Contractor Barnes & Sons Pipe Pulling Co.
Address P.O. Box 313 Russell, Kansas

STATE OF Kansas, COUNTY OF Sedgwick, ss.
Milton Glickman (employee of owner) or (owner or operator) of the above-described well, being first duly sworn on oath, says: That I have knowledge of the facts, statements, and matters herein contained and the log of the above-described well as filed and that the same are true and correct. So help me God.

(Signature) Milton Glickman Partner
P. O. Box 3104, Wichita, Kansas
(Address)

SUBSCRIBED AND SWORN TO before me this 18th day of March, 1965

My commission expires November 19, 1967
Lorella Schauf Notary Public.

RECEIVED
STATE CORPORATION COMMISSION

15.009.15594.0000

JAN 25 1941

P. SCHEUFLER NO. 4

CONSERVATION DIVISION
Wichita, Kansas

Spudded: February 5, 1941
Drlg. Completed: February 22, 1941
Potential Taken: March 22, 1941

Loc: 1320' S & 440' E of NW Corner
of Sec. 24, Twp. 20S, Rge. 12W,
Barton County, Kansas

From	To	Formation	From	To	Formation
0	212	Surface sand	2453	3019	Lime & shale
212	260	Red rock & shale	3019	3090	Lime
260	957	Red bed & shale	3090	3133	Shale
957	1460	Shale	3133	3288	Lime & shale
1460	2043	Shale & lime	3288	3333	Shale
2043	2239	Shale	3333	3373	Lime
2239	2333	Lime & shale		3372'	Total depth from cement floor level.
2333	2453	Shale			

Elevation from derrick floor level 1805'.

Run 240'10" of 9-5/8"OD 43# 5sq.-thd Class R, Range 3, Extreme Line surface casing; set at 239'; cemented with 175 sacks of cement.

Top of Arbuckle Lime 3323'.

Run 3348'2" of 6"OD 15# 8-thd J-55 E. W. casing; set at 3324'; cemented with 250 sacks of cement, run 6"OD 8-thd DP thread form "Bakblu" male & female float collar and 6"OD 8-thd DP thread form "Bakblu" guide shoe.

2/24/41 - Underreamed from 3326' to 3371' - Total fillup w/ oil 2900' in 48 hrs.

2/25/41 - Swabbed 21 bbls. of oil in 4 hours.

3/6/41 - Run and set 65' of 4-1/2" OD Liner on bottom - Swabbed 40 bbls. of oil in 10 hours.

3/7/41 - Swabbed 40 bbls. of oil in 8 hours.

3/8/41 - Acidized w/ 1000 gals. of Morgan acid - time 7:30 - Max. press. on csg. 700# - press. dropped to 500# - used 112 bbls. of load oil.

3/10/41 - Swabbed load oil and swabbed 150 bbls. of oil and 189 bbls. of water in 4 1/2 hours.

3/11/41 - Swabbed 444 bbls. of oil and 50 bbls. of water in 8 hours, last 2 hours did not swab any water.

3/22/41 - On physical potential test the well pumped 269.61 bbls. of oil and 195 bbls. of water in 8 hours, giving the well a 24 hour potential of 809 bbls. of oil and 585 bbls. of water.

Total depth 3372'

Note: Above footages except elevation calculated from cement floor level.

FLD-JL 5/6/41 LPG (3) File (1)

I, the undersigned, being first duly sworn upon oath, state that this well record is true, correct and complete according to the records of this office and to the best of my knowledge and belief.

T. L. D.
Name and title of representative of company

Subscribed and sworn to before me this the 6th day of May, 1941.

My Commission expires October 21, 1944 James M. Shire
Notary Public