


Give All Information Completely
Make Required Affidavit
Mail or Deliver Report to:
Conservation Division
State Corporation Commission
212 No. Market
Wichita, Kansas

WELL PLUGGING RECORD

Pawnee County, Sec. 9 Twp. 23 Rge. (E) 17 (W)

Location as "NE/CNW/SW" or footage from lines SW SW NE
Lease Owner Colorado Oil Company
Lease Name Hutchinson "D" Well No. 2
Office Address 915 Union Natl. Bldg., Wichita, Kansas 67202
Character of Well (completed as Oil, Gas or Dry Hole) Oil
Date well completed November 5 19 54
Application for plugging filed December 15 19 69
Application for plugging approved December 16 19 69
Plugging commenced December 16 19 69
Plugging completed January 15 19 70
Reason for abandonment of well or producing formation Depleted

NORTH

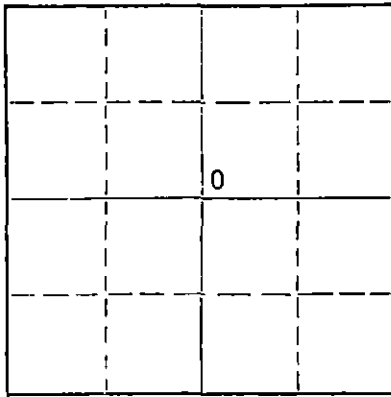

Locate well correctly on above Section Plat

If a producing well is abandoned, date of last production April 3 19 67
Was permission obtained from the Conservation Division or its agents before plugging was commenced? Yes

Name of Conservation Agent who supervised plugging of this well Leo Massey
Producing formation Congl. Chert Depth to top 4228 Bottom _____ Total Depth of Well 4360 Feet
Show depth and thickness of all water, oil and gas formations.

OIL, GAS OR WATER RECORDS

CASING RECORD

FORMATION	CONTENT	FROM	TO	SIZE	PUT IN	PULLED OUT
				8-5/8"	248	None
				5-1/2"	4359'	3133'

Describe in detail the manner in which the well was plugged, indicating where the mud fluid was placed and the method or methods used in introducing it into the hole. If cement or other plugs were used, state the character of same and depth placed, from _____ feet to _____ feet for each plug set.

Checked bottom, ran sand to 4200', dumped 5 sacks of cement.
Shot pipe at 3238', 3150', worked pipe loose and pulled 26 joints.
Halliburton pumped 5 sacks hulls, 20 sacks of mud and 100 sacks of cement to plug well.

PLUGGING COMPLETE.

RECEIVED
STATE CORPORATION COMMISSION
JAN 27 1970
CONSERVATION DIVISION
Wichita, Kansas

(If additional description is necessary, use BACK of this sheet)

Name of Plugging Contractor Knight Casing Pulling Co., Inc.
Address Chase, Kansas

STATE OF Kansas COUNTY OF Sedgwick, ss.
Bill K. Henrichs (employee of owner) or (owner or operator) of the above-described well, being first duly sworn on oath, says: That I have knowledge of the facts, statements, and matters herein contained and the log of the above-described well as filed and that the same are true and correct. So help me God.

(Signature) Bill K. Henrichs
915 Union Natl. Bldg., Wichita, Kansas 67202
(Address)

SUBSCRIBED AND SWORN to before me this 26th day of January, 19 70

My commission expires February 19, 1973

Betty J. McElwain
Betty J. McElwain Notary Public.

15-145-00843-0000

HONAKER DRILG., INC.
2008 LAKIN
GREAT BEND, KANSAS

RECEIVED
STATE CORPORATION COMMISSION
DEC 16 1969
CONSERVATION DIVISION
Wichita, Kansas

DRILLERS LOG

Hutchinson 'D' No. 2
Loc: SW SW NE
Sec: 9-23-17
Pawnee County, Kansas
Contractor: Honaker Drilg., Inc.

Comm: 10-17-54
Comp: 10-28-54
Total Depth: 4360'
Elevation: 2105 D.F.
Casing: 8-5/8" @ 255',
5-1/2" @ 4359'.

0	41	Sand & Gravel.	
41	190	Sand & Clay.	
190	390	Blue Shale.	8-5/8" casing cemented @
390	650	Red Bed.	255' with 175 sacks cement
650	1150	Red Bed & Shale.	and 4 sacks calcium chloride.
1150	1178	Anhydrite.	
1178	1580	Shale & Shells.	
1580	1640	Salt.	
1640	1810	Shale & Shells.	
1810	3910	Lime & Shale.	
3910	4268	Lime.	
4268	4360	Lime & Chert.	
4360		Total Rotary Depth.	5-1/2" casing cemented @
			4359' with 175 sacks cement.

I certify that this is the true and correct copy of the
above log, to the best of my knowledge.

A. J. Towler

Subscribed and sworn to before me this 30th day of
October, 1954.

Ernest D. Fisher
Notary Public

My Commission Expires: 6-25-55