


15-145-01102-0000

Give All Information Completely
Make Required Affidavit
Mail or Deliver Report to:
Conservation Division
State Corporation Commission
212 North Market Insurance Bldg.
Wichita, Kansas

WELL PLUGGING RECORD

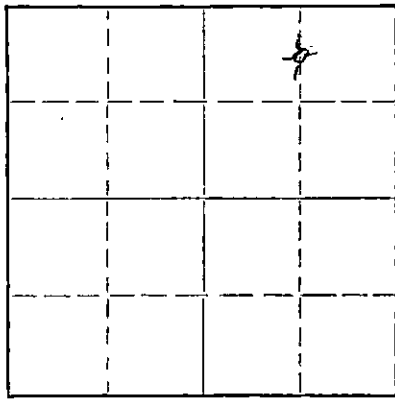

Locate well correctly on above Section Plat

Pawnee County, Sec. 7 Twp. 23S Rge. (E) 17 (W)
Location as "NE/CNW/SW" or footage from lines C N/2 N/2 NE/4
Lease Owner Peel-Hardman Oil Operators
Lease Name Orange Township Well No. 1
Office Address R. R. #3, Box 144B, Wichita 20, Kansas
Character of Well (completed as Oil, Gas or Dry Hole) Oil Well
Date well completed March 2, 19 55
Application for plugging filed January 21, 19 59
Application for plugging approved January 23, 19 59
Plugging commenced February 4, 19 59
Plugging completed February 25, 19 59
Reason for abandonment of well or producing formation No longer a commercial producer.
If a producing well is abandoned, date of last production January 19 59
Was permission obtained from the Conservation Division or its agents before plugging was commenced? Yes

Name of Conservation Agent who supervised plugging of this well Frank Broadfoot
Producing formation _____ Depth to top _____ Bottom _____ Total Depth of Well 4216 Feet
Show depth and thickness of all water, oil and gas formations.

OIL, GAS OR WATER RECORDS

CASING RECORD

FORMATION	CONTENT	FROM	TO	SIZE	PUT IN	PULLED OUT
		0	210'	8 5/8"	210'	None
		0	4215'	5 1/2"	4215'	2897'

Describe in detail the manner in which the well was plugged, indicating where the mud fluid was placed and the method or methods used in introducing it into the hole. If cement or other plugs were used, state the character of same and depth placed, from _____ feet to _____ feet for each plug set.

Filled hole with sand from 4216' to 4200'. Put 4 sacks cement in bottom of hole with dump bailer. Pump 20 sacks mud down between 8 5/8" and 5 1/2" casing to kill water. Pull pipe from hole. Pump 20 sacks mud and 75 sacks cement down well with cement plug to bottom of cellar.

RECEIVED
STATE CORPORATION COMMISSION
JAN 30 1963
1-30-1963
CONSERVATION DIVISION
Wichita, Kansas

(If additional description is necessary, use BACK of this sheet)
Name of Plugging Contractor Barnes & Sons Pipe Pulling Co.
Address Russell, Kansas

STATE OF KANSAS COUNTY OF SEDGWICK, ss.
Wm Herbert (employee of owner) or (owner or operator) of the above-described well, being first duly sworn on oath, says: That I have knowledge of the facts, statements, and matters herein contained and the log of the above-described well as filed and that the same are true and correct. So help me God.

(Signature) [Signature]
R. R. #3, Box 144B, Wichita 20, Kansas
(Address)

SUBSCRIBED AND SWORN to before me this 21 day of January, 19 63

My commission expires March 4, 1966
Marian M. Herbert
Marian M. Herbert Notary Public.



15-145-01102-0000

DRILLER'S LOG

Company: Peel-Hardman Oil & Gas Producers
Farm Name: Orange Township Well No. 1
Total Depth: 4216'
Comm.: 2-10-55 Comp.: 2-22-55
Contractor: Glenn W. Peel
Casing: 8 5/8" 210' cem.
5 1/2" 4215' cem.

C N/2 N/2 NE (100' FNL)
Sec. 7, Twp. 23S, Rge. 17W,
County, Pawnee,
Kansas
Elevation:
Production:

Figures below indicate bottoms of formations:

Sand	0 -	35'
Hard Gravel		70
Sand and shale		210
Shale		1085
Anhydrite or Hard Lime		1135
Shale and sand		1305
Shale		1920
Shale and Lime		1970
Lime		2820
Lime and shale		3595
Lime		4216
Total Depth		4216

This is to certify that the above information is to the best of our knowledge, true and correct.

PEEL-HARDMAN OIL OPERATORS

BY: *Glenn W. Peel*

SUBSCRIBED AND SWORN to before me this 21st day of January, 1959.

My commission expires: March 4, 1962.

Marian M. Herbert
Notary Public

RECEIVED
STATE CORPORATION COMMISSION
JAN 22 1959
CONSERVATION DIVISION
Wichita, Kansas

PLUGGING
FILE SEC 7 T 23 R 17W
BOOK PAGE 11 LINE 22