


15-145-01096-0000

STATE OF KANSAS
STATE CORPORATION COMMISSION

WELL PLUGGING RECORD

Give All Information Completely
Make Required Affidavit
Mail or Deliver Report to
Conservation Division
State Corporation Commission
800 Bitting Building
Wichita, Kansas

Pawnee County, Sec. 7 Twp. 23S Rge. 17 (E) W (W)
Location as "NE/CNW/SW" or footage from lines NW NW NE
Lease Owner Peel-Hardman Oil & Gas Producers
Lease Name Orange Township Well No. 2
Office Address P.O. Box 359, Hoisington, Kansas
Character of Well (completed as Oil, Gas or Dry Hole) Dry Hole
Date well completed May 6, 1955
Application for plugging filed May 6, 1955
Application for plugging approved May 6, 1955
Plugging commenced May 6, 1955
Plugging completed May 6, 1955
Reason for abandonment of well or producing formation Dry Hole

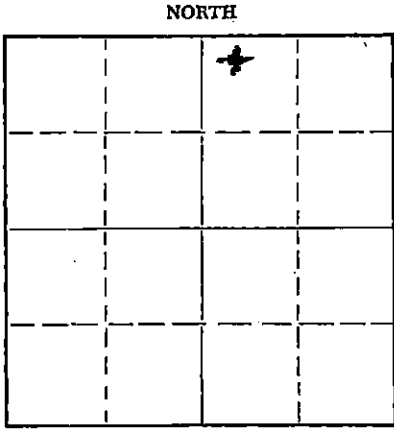

Locate well correctly on above Section Plat

If a producing well is abandoned, date of last production 19
Was permission obtained from the Conservation Division or its agents before plugging was commenced? Yes

Name of Conservation Agent who supervised plugging of this well Warren Horner
Producing formation Depth to top Bottom Total Depth of Well 4278 Feet
Show depth and thickness of all water, oil and gas formations.

OIL, GAS OR WATER RECORDS

CASING RECORD

FORMATION	CONTENT	FRDM	TO	SIZE	PUT IN	PULLED OUT
		0	182'	8 5/8"	182'	None

Describe in detail the manner in which the well was plugged, indicating where the mud fluid was placed and the method or methods used in introducing it into the hole. If cement or other plugs were used, state the character of same and depth placed, from feet to feet for each plug set.

4278' to 269 1/2' - heavy rotary mud
269 1/2' to 268' - wooden plug
268' to 6' - 85 sacks cement pumped by Halliburton
6' to surface - cellar

5-11-1955

STATE CORP.

MAY 1 1955

CONSERVATION DIVISION

Name of Plugging Contractor Glenn W. Peel
Address P.O. Box 359, Hoisington, Kansas

STATE OF KANSAS, COUNTY OF BARTON, ss.
Glenn W. Peel (employee of owner) or (owner or operator) of the above-described well, being first duly sworn on oath, says: That I have knowledge of the facts, statements, and matters herein contained and the log of the above-described well as filed and that the same are true and correct. So help me God. GLENN W. PEEL

(Signature) BY: *Manan M. Herbert*
P.O. Box 359, Hoisington, Kansas (Address)

SUBSCRIBED AND SWORN TO before me this 10th day of May, 1955

My commission expires June 4, 1955 Notary Public.

PLUGGING
FILE SEC 7 T 23 R 17
BOOK PAGE 17 LINE 3/4

15-145-01056-0000

DRILLERS' LOG

Company: Peel-Hardman Oil & Gas Producers

NW NW NE
Sec. 7, Twp. 23S, Rge. 17W,

Farm Name: Orange Township Well No. 2

Total Depth: 4278'

County: Pawnee,
Kansas

Comm: 4-23-55 Comp: 5-6-55

Contractor: Glenn W. Peel

Elevation:

Casing: 8 5/8" 182' cem.

Production: Dry

Figures below indicate bottoms of formations:

Surface clay and sand	0 -	60
Sand and shale		182
Shale, red bed and shale		935
Shale		1235
Shale and shells		1565
Shale, shells and lime streaks		1950
Lime and shale		2100
Lime and shale streaks		2255
Lime and shale		2340
Lime		2755
Lime and shale		3350
Lime		3555
Lime and shale streaks		3650
Lime		4240
Cherty Lime		4278
Total Depth		4278

This is to certify that the above information is to the best of my knowledge, true and correct.

GLENN W. PEEL

BY: *Glenn W. Peel*

SUBSCRIBED AND SWORN to before me this 10th day of May, 1955.

My commission expires: June 4, 1955

Marion M. Herbert
Notary Public

RECEIVED
REGISTRATION COMMISSION
MAY 11 1955
REGISTRATION DIVISION
Wichita, Kansas

PLUGGING
FILE SEC 7 T23 R17W
BOOK PAGE 117 LINE 31