


WELL PLUGGING RECORD

Give All Information Completely  
Make Required Affidavit  
Mail or Deliver Report to:  
Conservation Division  
State Corporation Commission  
211 No. Broadway  
Wichita, Kansas

NORTH

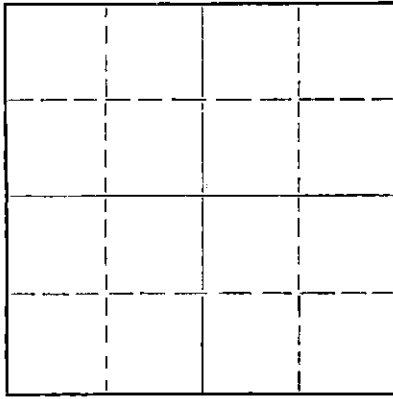

Locate well correctly on above Section Plat

Pawnee County. Sec. 7 Twp. 23 Rge. 17W (E) (W)  
Location as "NE/CNW/SW" or footage from lines CN/2 NW NW  
Lease Owner Bennett & Roberts Drilling Co.  
Lease Name Garfield "A" Well No. 1  
Office Address Russell, Ks.  
Character of Well (completed as Oil, Gas or Dry Hole) Dry Hole  
Date well completed 2/21 19 56  
Application for plugging filed 4/19 19 56  
Application for plugging approved 4/20 19 56  
Plugging commenced 4/25 19 56  
Plugging completed 5/1 19 56  
Reason for abandonment of well or producing formation

If a producing well is abandoned, date of last production 19  
Was permission obtained from the Conservation Division or its agents before plugging was commenced? Yes

Name of Conservation Agent who supervised plugging of this well R. M. Brundege  
Producing formation Depth to top Bottom Total Depth of Well 4437 Feet  
Show depth and thickness of all water, oil and gas formations.

OIL, GAS OR WATER RECORDS

CASING RECORD

FORMATION	CONTENT	FROM	TO	SIZE	PUT IN	PULLED OUT
				8 5/8"	808'	None
				5 1/2"	4437'	3319'

Describe in detail the manner in which the well was plugged, indicating where the mud fluid was placed and the method or methods used in introducing it into the hole. If cement or other plugs were used, state the character of same and depth placed, from feet to feet for each plug set.

Plugged back with crushed rock to 4245', dumped 5 sax cement @ 4245' with dump bailer. Top of cement, 4210'. Filled hole with mud to 400', set rock bridge, dumped 20 sax cement. Top of cement 340'. Filled hole with mud to 35', set rock bridge, dumped 10 sax cement for cap.

RECEIVED  
STATE CORPORATION COMMISSION

MAY 8 1956 5-8-1956

CONSERVATION DIVISION  
Wichita, Kansas

(If additional description is necessary, use BACK of this sheet)  
Name of Plugging Contractor Miller Casing Pulling Co.  
Address Great Bend, Ks.

STATE OF KANSAS COUNTY OF RUSSELL, ss.  
Harold Wurst (employee of owner) or (owner or operator) of the above-described


well, being first duly sworn on oath, says: That I have knowledge of the facts, statements, and matters herein contained and the log of the above-described well as filed and that the same are true and correct. So help me God.

(Signature) Harold Wurst  
Russell, Ks.  
(Address)

SUBSCRIBED AND SWORN TO before me this 7th day of May, 19 56

My commission expires 6/17/58

Notary Public.

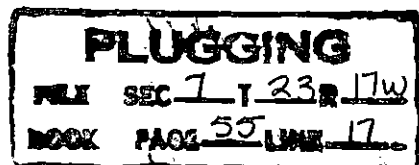

15-145-00986-0000

Bennett & Roberts Drilling Co.  
Garfield "A" #1

NW NW of Section 7-23-17  
Pawnee County, Kansas

R.T.D. 4437\*

Commenced 1/25/56  
Completed 2/11/56

Tops:	
Cimarron Anhydrite	1130
Heebner Shale	3678
Toronto Lime	3695
Douglas Shale	3709
Brown Lime	3782
Lansing K.C.	3793
Basal K.C.	4160
Cherokee Shale	4223
Conglomerate Shale	4240
Conglomerate Chert	4252
Mississippi Chert	4305
Misner Sandstone	4367
Viola Chert	4407

Casing Record

8 5/8" Set @ 808' w/400 sx cmt  
5 1/2" Set @ 4437' w/150 sx cmt

----- Figures Indicate Bottom of Formation -----

Surface Soil & Sand	55
Yellow Clay	65
Sandy Clay	85
Grey Shale, Lime Shells	130
Sand	165
Blue Shale	225
Blue Shale & Shells	375
Red Bed	490
Red Bed & Gray Shale	575
Sand	680
Sand	720
Red Bed	1130
Anhydrite	1160
Shael	1185
Shale & Shells & Red Bed	1440
Shale & Lime Streaks	1485
Shale & Shells	1600
Shale & Streaks Lime	1800
Lime & Shale	2110
Lime	2515
Lime & Shale	2595
Lime	2745
Shale & Lime Streaks	2775
Lime & Shale	3135
Shale & Broken Lime	3160
Shale & Lime Streaks	3305
Lime & Shale	3785
Lime	4256
Conglomerate	4267
Lime & Shale (Cong.)	4305
Cong. & Chert	4359
Cherty Mississippi	4369
Sand & Shale	4400
Lime & Chert	4437

STATE OF KANSAS)  
RUSSELL COUNTY ) SS.

**PLUGGING**  
FILE SEC 7 T 23 R 17W  
BOOK PAGE 55 LINE 17

I hereby certify that the above information is correct to the best of my knowledge.

BENNETT & ROBERTS DRILLING CO.

By John R. Brown

Subscribed and sworn to before me this 20th day of February, 1956.

My Commission Expires 6/17/58

Charles L. ...  
Notary Public