

15-145-00301-0000

STATE OF KANSAS
STATE CORPORATION COMMISSION


Form CP-4

WELL PLUGGING RECORD

Give All Information Completely
Make Required Affidavit
Mail or Deliver Report to:
Conservation Division
State Corporation Commission
212 No. Market
Wichita, Kansas

Pawnee County, Sec. 7 Twp. 23 Rge. 17 (E) (W) X

Location as "NE/CNW/SW" or footage from lines SE NE NW
Lease Owner Bovaird Supply Co.
Lease Name Godfrey Well No. #1
Office Address Box 48 Great Bend, Kansas
Character of Well (completed as Oil, Gas or Dry Hole) _____
Date well completed _____ 19____
Application for plugging filed 7-20-72 19____
Application for plugging approved _____ 19____
Plugging commenced 8-2-72 19____
Plugging completed 8-11-72 19____
Reason for abandonment of well or producing formation _____

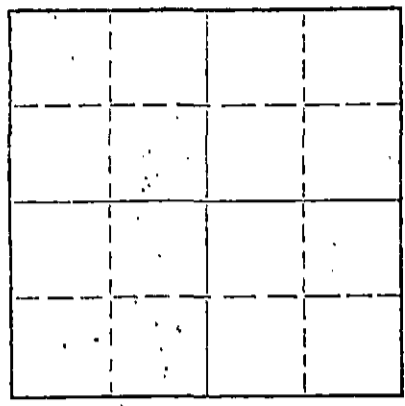

Locate well correctly on above Section Plat

If a producing well is abandoned, date of last production _____ 19____
Was permission obtained from the Conservation Division or its agents before plugging was commenced? _____

Name of Conservation Agent who supervised plugging of this well Donald Truan
Producing formation _____ Depth to top _____ Bottom _____ Total Depth of Well 4329' Feet
Show depth and thickness of all water, oil and gas formations.

OIL, GAS OR WATER RECORDS CASING RECORD

FORMATION	CONTENT	FROM	TO	SIZE	PUT IN	PULLED OUT
				5 1/2"	4327'	3341.46'
				8 5/8"	210'	

Describe in detail the manner in which the well was plugged, indicating where the mud fluid was placed and the method or methods used in introducing it into the hole. If cement or other plugs were used, state the character of same and depth placed, from _____ feet to _____ feet for each plug set.

Made bottom hole plug back with sand to 3875'. Mixed and ran 5 sacks cement thru dump bailer.
Squeezed hole with 4 sacks hulls - 25 sacks gel. Released plug and 1 sacks hulls and 100 sacks common cement with 2% C.C.

RECEIVED
STATE CORPORATION COMMISSION
AUG 14 1972
CONSERVATION DIVISION
Wichita, Kansas

8-14-1972

(If additional description is necessary, use BACK of this sheet)


Name of Plugging Contractor Southwest Casing Pulling Co.
Address Box 364 Great Bend, Kansas

STATE OF Kansas, COUNTY OF Barton, ss.
Southwest Casing Pulling Co. (employee of owner) or (owner or operator) of the above-described well, being first duly sworn on oath, says: That I have knowledge of the facts, statements, and matters herein contained and the log of the above-described well as filed and that the same are true and correct. So help me God.

(Signature) W. C. Spencer Sec
Box 364 Great Bend, Kansas
(Address)

SUBSCRIBED AND SWORN TO before me this 12 day of August, 1972

My commission expires October 1972

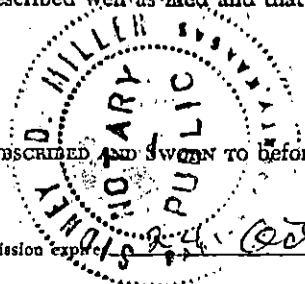

Sidney D. Miller
Notary Public.

DRILLER'S LOG

15-145-60301-0000

COMPANY: Hilton Drilling Company, Inc. LOCATION: SE of NE of NW
 Sec. 7-238-17d
 Pawnee County, Kansas
 CONTRACTOR: Hilton Drilling Company, Inc.
 FARM NAME: Godfrey No. 1 ELEVATION: 2068 D.F.
 COMMENCED: 3-29-55 Casing Used: 8-5/8" at 210' with 200 sxs.
 COMPLETED: 4-12-55 5-1/2" at 4327' with 150 sxs.

Sand, Gravel and Clay	120
Shale	340
Red Bed	560
Sand	650
Red Bed and Sand streaks	800
Red Bed	1110
Anhydrite	1140
Shale and Shells	1250
Salt, Shale and Shells	1735
Shale and Lime	2130
Lime	2575
Shale and Lime	3315
Lime	3539
Shale and Lime	3633
Lime	3687
Shale and Lime	3780
Lime	4194
Shale, Lime and Chert	4329
Total Depth	4329

RECEIVED
 STATE CORPORATION COMMISSION
 JUL 21 1972
 CONSERVATION DIVISION
 Wichita, Kansas

STATE OF KANSAS)
) ss.
 COUNTY OF BARTON)

I, the undersigned, being duly sworn on oath, state that the above statement and log are true and a correct record and log of the well drilled at the location above described.

HILTON DRILLING COMPANY, INC.

Henry Reason
 Henry Reason, Secretary

Subscribed and sworn to before me this 12th day of April, 1955

My commission expires January 26, 1959

Carmen Bernhardt Leiker
 Notary Public