


SP

Give All Information Completely
Make Required Affidavit
Mail or Deliver Report to:
Conservation Division
State Corporation Commission
211 No. Broadway
Wichita, Kansas

WELL PLUGGING RECORD

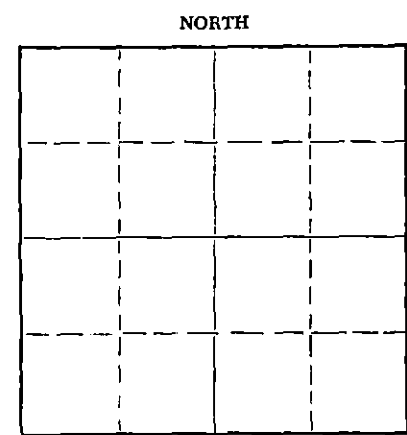

Locate well correctly on above
Section Plat

Pawnee County, Sec. 10 Twp. 23 Rge. 17 (E) (W) x
Location as "NE/CNW&SW&" or footage from lines C of S/2 NW NW
Lease Owner Rock Island Oil & Ref. Co., Inc.
Lease Name Anderson "B" Well No. 5
Office Address 321 W. Douglas, Wichita, Kansas
Character of Well (completed as Oil, Gas or Dry Hole) _____
Date well completed _____ 19____
Application for plugging filed _____ 19____
Application for plugging approved _____ 19____
Plugging commenced 12-4-64 _____ 19____
Plugging completed 12-14-64 _____ 19____
Reason for abandonment of well or producing formation _____

If a producing well is abandoned, date of last production _____ 19____
Was permission obtained from the Conservation Division or its agents before plugging was commenced? _____

Name of Conservation Agent who supervised plugging of this well Eldon Petty
Producing formation _____ Depth to top _____ Bottom _____ Total Depth of Well 4270' Feet
Show depth and thickness of all water, oil and gas formations.

OIL, GAS OR WATER RECORDS

CASING RECORD

FORMATION	CONTENT	FROM	TO	SIZE	PUT IN	PULLED OUT
						2494.58'

Describe in detail the manner in which the well was plugged, indicating where the mud fluid was placed and the method or methods used in introducing it into the hole. If cement or other plugs were used, state the character of same and depth placed, from _____ feet to _____ feet for each plug set.

Made plug back with sand to 4180', mixed and ran 4 sacks cement thru dump baler.
Squeezed hole with 35 sacks gel and 100 sacks cement.

RECEIVED
STATE CORPORATION COMMISSION

DEC 18 1964
12-18-1964

CONSERVATION DIVISION
Wichita, Kansas

(If additional description is necessary, use BACK of this sheet)

Name of Plugging Contractor Southwest Casing Pulling Co., Inc.
Address Box 364, Great Bend, Kansas

STATE OF Kansas, COUNTY OF Barton, ss.
Southwest Casing Pulling Co., Inc. (employee of owner) or (owner or operator) of the above-described well, being first duly sworn on oath, says: That I have knowledge of the facts, statements, and matters herein contained and the log of the above-described well as filed and that the same are true and correct. So help me God.

(Signature) W. C. Spencer Sec.
Box 364, Great Bend, Kansas
(Address)

SUBSCRIBED AND SWORN TO before me this 17 day of December, 19 64

My commission expires 24 October 1968
Sidney D. Miller
Notary Public.

Send to K.C.C.

Rock Island O&R
ANDERSON "B#5"

15-145-01339-0000

C S/2 NW/4 NW/4 of Section 10-23S-17W Pawnee County, Kansas

Rigged up Rotary Tools 11/5/55

Ran 9 Jts. (258') 8 5/8" Surface Pipe set at 233'. Cemented with 135 sacks cement, 2% Gel.

Tore down Rotary Tools 11/20/55

Ran 135 Jts. (4271.24') 5 1/2" new casing set at 4258'. Cemented with 150 sacks common cement.

<u>FORMATION</u>	<u>FROM</u>	<u>TO</u>
Shale & sand	0'	233'
Sand, shale & shells	233	890
Redbed, shells & shale	890	1120
Anhydrite	1120	1182
Shale & shells	1182	1620
Shale	1620	1930
Lime & shale	1930	2020
Lime	2020	2108
Shale & lime	2108	2300
Lime & sand w/shale streaks	2300	2371
Lime & shale	2371	2570
Lime w/shale & sand streaks	2570	2637
Lime & shale	2637	2720
Shale w/lime streaks	2720	2885
Shale & lime	2885	3365
Lime, sand & shale	3365	3470
Lime & shale	3470	3644
Lime	3644	3690
Lime & shale	3690	3772
Lime	3772	3810
Lime w/shale streaks	3810	3857
Lime	3857	3873
Lime & shale	3873	3918
Lime	3918	4115
Lime & shale	4115	4162
Lime, shale & conglomerate	4162	4222
Lime	4222	4240
Conglomerate	4240	4270 TD

RECEIVED
STATE CORPORATION COMMISSION
DEC 24 1964
CONSERVATION DIVISION
Wichita, Kansas

I, W. M. Barnett, do hereby certify that the foregoing log is true and correct, to the best of my knowledge and belief.

W. M. Barnett

Subscribed and sworn to before me this 21st day of November, 1955

James Harvey

My Commission Expires: July 29, 1957