


Give All Information Completely
Make Return Affidavit
Mail or Deliver Report to:
Conservation Division
State Corporation Commission
800 Bitting Building
Wichita, Kansas

WELL PLUGGING RECORD

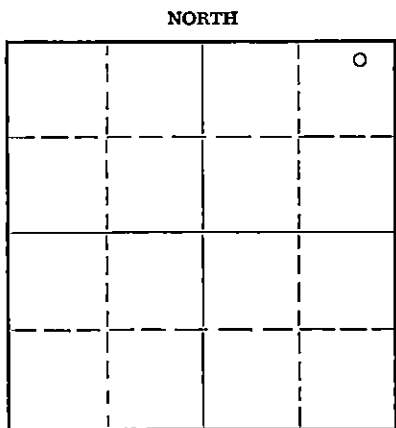

Locate well correctly on above
Section Plat

Pawnee County, Sec. 10 Twp. 23 Rge. 17 (E) W (W)
Location as "NE/CNW/SW" or footage from lines: NE NE NE
Lease Owner Colorado Oil and Gas Corporation
Lease Name Kasselman Well No. 1
Office Address Box 1030, Wichita, Kansas
Character of Well (completed as Oil, Gas or Dry Hole) Dry Hole.
Date well completed 3-4 19 56
Application for plugging filed 3-4 19 56
Application for plugging approved 3-4 19 56
Plugging commenced 3-4 19 56
Plugging completed 3-4 19 56
Reason for abandonment of well or producing formation Dry Hole.

If a producing well is abandoned, date of last production 19
Was permission obtained from the Conservation Division or its agents before plugging was commenced? Yes

Name of Conservation Agent who supervised plugging of this well R. M. Brundage
Producing formation Cherty Cong. (Penn.) Depth to top 4157 Bottom _____ Total Depth of Well 4289' Feet
Show depth and thickness of all water, oil and gas formations.

OIL, GAS OR WATER RECORDS

CASING RECORD

FORMATION	CONTENT	FROM	TO	SIZE	PUT IN	PULLED OUT
				8 5/8"	243	None

Describe in detail the manner in which the well was plugged, indicating where the mud fluid was placed and the method or methods used in introducing it into the hole. If cement or other plugs were used, state the character of same and depth placed, from _____ feet to _____ feet for each plug set.

Filled hole with mud. Put two (2) top cement plugs in 8 5/8" and pumped in 100 sacks of cement, filling hole from approximately 300' to surface with cement. Maximum Press.: 400#. Standing Press: 150#. Cement settled 15' in 24 hours.

(If additional description is necessary, use BACK of this sheet)

Name of Plugging Contractor Globe Oil Well Cementing Co.
Address Great Bend, Kansas

STATE OF Kansas, COUNTY OF Sedgwick, ss.
Thomas D. Pyburn (employee of owner) or (owner or operator) of the above-described well, being first duly sworn on oath, says: That I have knowledge of the facts, statements, and matters herein contained and the log of the above-described well as filed and that the same are true and correct. So help me God.

(Signature) Thomas D. Pyburn
Box 1030, Wichita, Kansas
(Address)

SUBSCRIBED AND SWORN TO before me this 12th day of March, 19 56

My commission expires August 24, 1957

H. A. Bilson
H. A. Bilson Notary Public.

24-7368-5 3-53-20M

PLUGGING
FILE SEC 10 T 23 R 17 W
BOOK PAGE 43 LINE 36

RECEIVED
STATE CORPORATION COMMISSION
MAR 13 1956
3-13-1956
CONSERVATION DIVISION
WICHITA, KANSAS

15-145-01082-0000

DRILLERS LOG

Kasselman No. 1
Loc: 440' South of North Line
440' West of East Line
Sec: 10-23S-17W
Pawnee County, Kansas
Company: Colorado Oil & Gas Corporation
Contractor: Honaker Drlg., Inc.

Comm: 2-21-56
Comp: 3-4-56
Rotary Total Depth: 4289
Casing: 8 5/8" at 243'
D & A

0	95	Top Soil & Sand	
95	130	Sand & Gravel	
130	243	Red Bed & Shale	
243	370	Blue Shale	8 5/8" casing cemented at
370	400	Water Sand	243' with 175 sacks cement
400	590	Red Bed	and 4 sacks calcium chloride
590	650	Dakota Sand	
650	870	Red Bed	
870	1120	Shale & Red Bed	
1120	1150	Anhydrite	
1150	1550	Shale & Shells	
1550	1640	Salt	
1640	3940	Lime & Shale	
3940	4150	Lime	
4150	4157	Lime & Shale	
4157	4210	Lime, Shale & Chert	
4210	4226	Lime	
4226	4289	Lime & Chert	D & A
4289		Total Rotary Depth	

I certify that this is with the true and correct copy of the above log to the best of my knowledge.

H. S. Forbes
H. S. Forbes

Subscribed and sworn to before me this 7th day of March, 1956.

Kenneth G. Fischer
Kenneth G. Fischer, Notary Public

My Commission Expires: 6-25-59

PLUGGING
FILE SEC 10 T 23 R 17W
BOOK PAGE 43 LINE 36