


15-083-20972.0000

WELL PLUGGING RECORD

Give All Information Completely
 Make Required Affidavit

COUNTY HODGEMAN SEC. 10 TWP. 23S RGE. 17W E/W
 Location as in quarters or footage from lines:
C SW SW

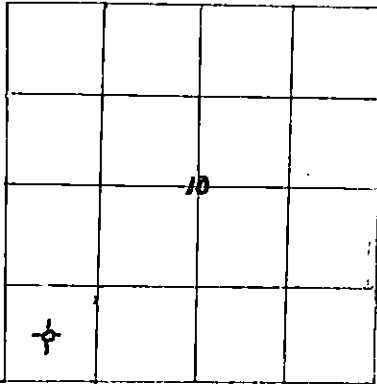

Locate Well
 correctly on above
 Section Platt.

Lease Owner Malexco
 Lease Name Wilson Well No. 1
 Office Address 1000 Bitting Building, Wichita, KS 67202
 Character of Well (Completed as Oil, Gas or Dry Hole): Dry Hole
 Date Well Completed April 15, 1982
 Application for plugging filed April 15, 1982
 Plugging commenced April 15, 1982
 Plugging completed April 15, 1982
 Reason for abandonment of well or producing formation _____

Was permission obtained from the Conservation Division or it's
 Agent's before plugging was commenced? yes

Name of Conservation Agent who supervised plugging of this well Steve Durantt
 Producing formation _____ Depth to top _____ bottom _____ T.D. 4670
 Show depth and thickness of all water, oil and gas formations.

OIL, GAS OR WATER RECORDS Casing Record

| Formation | Content | From | To | Size | Put in | Pulled Out |
|-----------|-------------------|--------|---------|--------------|--------|------------|
| Surface | shale | 0 | 335 | 8-5/8 | 332 | none |
| | cemented w/275 sx | 60/40 | posmix | 2%gel, 3%cc, | plug | |
| | down at 6:15 p.m. | 4-8-82 | by Sun. | cement did | circ. | |

Describe in detail the manner in which the well was plugged, indicating where the mud
 fluid was placed and the method or methods used in introducing it into the hold. If cement
 or other plugs were used, state the character of same and depth placed, from _____ feet
 to _____ feet for each plug set.

Plugged as follows w/130 sx 50/50 2%gel, 3%cc
 70 sx @ 900'
 40 sx @ 300'
 10 sx @ 40' w/solid plug
 10 sx in rat hole

(If additional description is necessary, use BACK of this sheet)

Name of Plugging Contractor Husky Drilling Co., Inc.


STATE OF KANSAS COUNTY OF SEDGWICK, ss.
Jon T. Williams, Jr. (employee of owner) or (owner or operator) of the
 above-described well, being first duly sworn on oath, says: That I have knowledge of the
 facts, statements, and matters herein contained and the log of the above-described well as
 filed and that the same are true and correct. So help me God.

RECEIVED
 STATE CORPORATION COMMISSION

(Signature) Jon T. Williams, Jr.
 200 East First, Suite 500, Wichita, KS
 (Address)

APR 21 1982

AND SWORN TO before me this 15th day of April, 19 82
Geraldine Stewart
 Geraldine Stewart Notary Public.

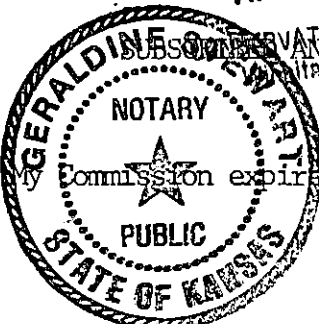

Commission expires: January 14, 1985