

TYPE

AFFIDAVIT OF COMPLETION FORM

ACO-1 WELL HISTORY

Compt. _____

SIDE ONE

Two (2) copies of this form shall be filed with the Kansas Corporation Commission, 200 Colorado Derby Building, Wichita, Kansas 67202, within thirty (30) days after the completion of a well, regardless of how the well was completed.

F Attach separate letter of request if the information is to be held confidential. If confidential, only file one copy. Information on Side One will be of public record and Side Two will then be held confidential.

Applications must be made on dual completion, commingling, salt water disposal, injection and temporarily abandoned wells.

C Attach one copy only wireline logs (i.e. electrical log, sonic log, gamma ray neutron log, etc.). (Rules 82-2-105 & 82-2-125) KCC# (316) 263-3238. No Log

LICENSE # 5004 EXPIRATION DATE 06/30/83

OPERATOR Vincent Oil Corporation API NO. 15-145-20,898-0600

ADDRESS 1110 KSB Bldg., 125 N. Market COUNTY Pawnee

Wichita, Kansas 67202 FIELD

** CONTACT PERSON Ruth Benjamin PROD. FORMATION

PHONE 262-3573

PURCHASER N/A LEASE Kasselmann

ADDRESS WELL NO. #2

WELL LOCATION W 1/2 SE

DRILLING Slawson Drilling Company, Inc. 990 Ft. from E Line and

CONTRACTOR 200 Douglas Bldg. 660 Ft. from S Line of

ADDRESS Wichita, Kansas 67202 the SE (Qtr.) SEC 10 TWP 23RGE 7W (W)

PLUGGING Kelso Casing Pulling (Office Use Only)

CONTRACTOR Box 347

ADDRESS Chase, Kansas 67524

TOTAL DEPTH 4360' PBTD

SPUD DATE 9/24/81 DATE COMPLETED 3/30/83

ELEV: GR 2095' DF KB 2101'


DRILLED WITH (XXXX) (ROTARY) XXXXXX TOOLS.

DOCKET NO. OF DISPOSAL OR REPRESSURING WELL BEING USED TO DISPOSE OF WATER FROM THIS LEASE

Amount of surface pipe set and cemented 295' DV Tool Used?

THIS AFFIDAVIT APPLIES TO: (Circle ONE) - Oil, Gas, Shut-in Gas, Dry Disposal, Injection, Temporarily Abandoned, OWWO. Other

ALL REQUIREMENTS OF THE STATUTES, RULES AND REGULATIONS PROMULGATED TO REGULATE THE OIL AND GAS INDUSTRY HAVE BEEN FULLY COMPLIED WITH.

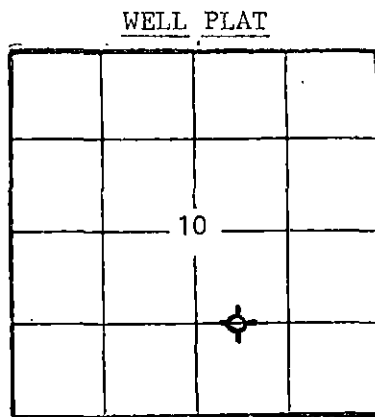

(Office Use Only) KCC [checked] KGS [checked] SWD/REP [checked] PLG. [checked]

A F F I D A V I T

RICHARD A. HIEBSCH, being of lawful age, hereby certifies that:

I am the Affiant, and I am familiar with the contents of the foregoing Affidavit. The statements and allegations contained therein are true and correct.

Richard A. Hiebsch (Name) Richard A. Hiebsch

SUBSCRIBED AND SWORN TO BEFORE ME this 15th day of April

19 83.



Ruth N. Benjamin (NOTARY PUBLIC) Ruth N. Benjamin

MY COMMISSION EXPIRES: June 17, 1985

** The person who can be reached by phone regarding any questions concerning this information. HIEBSCH STATE CORPORATION COMMISSION

*** IF HOLE IS PLUGGED A THIRD COPY IS NEEDED. FOR INJECTION OR DISPOSAL FOUR COPIES ARE NEEDED.

APR 19 1983

CONSERVATION DIVISION Wichita, Kansas

