

Confirmation

15.009.15599.0000


STATE OF KANSAS
STATE CORPORATION COMMISSION

Form CP-4

Give All Information Completely
Make Required Affidavit
Mail or Deliver Report to:
Conservation Division
State Corporation Commission
212 No. Market
Wichita, Kansas

WELL PLUGGING RECORD

NORTH

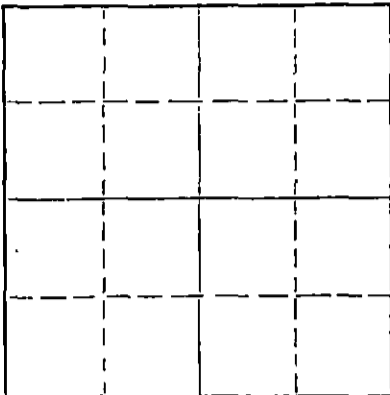

Locate well correctly on above
Section Plat

Barton County, Sec. 24 Twp. 20S Rge. 12W (E) (W)
Location as "NE/CNW/SW" or footage from lines 330 FWL 330 FSL
Lease Owner York Scheufler Lease, Phillips Petroleum Co. Owner
Lease Name York Scheufler Well No. 1
Office Address Box 287, Gt. Bend, Kan
Character of Well (completed as Oil, Gas or Dry Hole) Oil
Date well completed Mar 1949 19
Application for plugging filed 11-15-66 19
Application for plugging approved 11-17-66 19
Plugging commenced 12-8-66 19
Plugging completed 12-9-66 19
Reason for abandonment of well or producing formation uneconomical

If a producing well is abandoned, date of last production 11-20-66 19
Was permission obtained from the Conservation Division or its agents before plugging was commenced? yes

Name of Conservation Agent who supervised plugging of this well Donald Truan, 634 Sunset, Russell, Kan
Producing formation LKC Depth to top _____ Bottom _____ Total Depth of Well 3371 Feet
Show depth and thickness of all water, oil and gas formations.

OIL, GAS OR WATER RECORDS

CASING RECORD

FORMATION	CONTENT	FROM	TO	SIZE	PUT IN	PULLED OUT
				8-5/8	259'	none
				5 1/2"	3364	2330

Describe in detail the manner in which the well was plugged, indicating where the mud fluid was placed and the method or methods used in introducing it into the hole. If cement or other plugs were used, state the character of same and depth placed, from _____ feet to _____ feet for each plug set.

Plugged back from 3322 to 3100 with sand; 5 sx cement 3100 to 3060'. Well SD 11-20-66. Shot off at 2330', set 10' rock bridge 250 to 240'; 10 sx cement to 165'. Mudded hole to 40'; rock bridge to 30'; 10 sx cement to surface. Well P&A 1/4 p.m. 12-9-66.

RECEIVED
STATE CORPORATION COMMISSION
DEC 15 1966
CONSERVATION DIVISION
Wichita, Kansas
12-15-1966

(If additional description is necessary, use BACK of this sheet)
Name of Plugging Contractor LC Knight Casing
Address Chase, Kansas

STATE OF Kansas COUNTY OF Barton, ss.
A. T. Slagle Dist. Supt. (employee of owner) of the above-described well, being first duly sworn on oath, says: That I have knowledge of the facts, statements, and matters herein contained and the log of the above-described well as filed and that the same are true and correct. So help me God.

(Signature) A. T. Slagle
Box 287, Gt. Bend, Kan
(Address)

SUBSCRIBED AND SWORN to before me this 13th day of December, 19 66

Lura Lee Parks
Notary Public.

My commission expires 10-27-69

Formation Record

15.009.15599.0000

Lease York Scheufler

Well No. 1

FROM	TO	Formation	REMARKS
0	200	Surface Clay	
200	285	Shale	
285	584	Red Bed, Shale & Shells	
584	620	Anhydrite	
620	1400	Shale & Shells	
1400	3344	Lime & Shale	
3344	3358 TD	Lime	

Formation Tops:

Topoka	2703'
Heebner	2969'
Toronto	2987'
Brown Line	3095'
L.E.G.	3110'
Arbuckle	3341'

Lansing-Kansas City Zones:

- Zone #1 - 3114-18' - Poor porosity and trace of stain.
 Zone #2 - 3128-32' - Black residual stain.
 Zone #4 - 3148-53' - Porosity, possible oil. (Electric Log interpretation)
 Zone #6A - 3178-83' - Slight porosity, spotted live oil stain.
 Zone #6 - 3189-99' - Fair porosity, spotted stain to saturation, slight odor.
 Zone #7 - 3239-43' - Poor porosity, poor spotted stain.
 Zone #8 - 3258-66' - Slight porosity, poor spotted stain.
 Zone #9 - 3274-87' - Slight porosity, spotted stain, faint odor.

Electric Log - 1813 D.F.

RECEIVED
 OIL & GAS CORPORATION COMMISSION
 DEC 15 1966
 CONSERVATION DIVISION
 WICHITA, KANSAS