


WELL PLUGGING RECORD

Give All Information Completely
Make Required Affidavit
Mail or Deliver Report to:
Conservation Division
State Corporation Commission
800 Bitting Building
Wichita, Kansas

NORTH

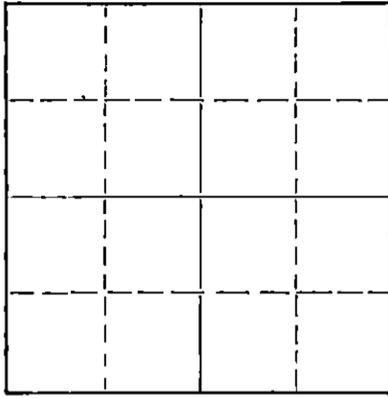

Locate well correctly on above
Section Plat

Barton County, Sec. 24 Twp. 20 Rge. 12 (E) (W)
Location as "NE/CNW&SW" or footage from lines SW NW SW
Lease Owner Cooperative Refinery Association
Lease Name Buckbee "A" Well No. 4
Office Address Box 765 Great Bend, Kansas
Character of Well (completed as Oil, Gas or Dry Hole) Oil
Date well completed November 8 19 48
Application for plugging filed September 17 19 56
Application for plugging approved September 19 19 56
Plugging commenced October 4 19 56
Plugging completed October 10 19 56
Reason for abandonment of well or producing formation Non-commercial production
If a producing well is abandoned, date of last production January 9 19 56
Was permission obtained from the Conservation Division or its agents before plugging was commenced? yes

Name of Conservation Agent who supervised plugging of this well R. M. Brundage
Producing formation _____ Depth to top _____ Bottom _____ Total Depth of Well 3379 Feet
Show depth and thickness of all water, oil and gas formations.

OIL, GAS OR WATER RECORDS

CASING RECORD

FORMATION	CONTENT	FROM	TO	SIZE	PUT IN	PULLED OUT
				8 5/8"	260	-0-
				5 1/2"	3356	2358.25'

Describe in detail the manner in which the well was plugged, indicating where the mud fluid was placed and the method or methods used in introducing it into the hole. If cement or other plugs were used, state the character of same and depth placed, from _____ feet to _____ feet for each plug set.

Sanded hole back from T.D. of 3379 to 3345. Dumped 5 sacks cement on sand top of cement 3305. Pulled 5 1/2" casing. Mudded hole to 235'. Set 10' rock bridge, top of bridge 225'. Dumped 20 sacks cement, top of cement 165'. Mudded hole to 45'. Set 10' rock bridge and dumped 10 sacks cement for top and cap.

(If additional description is necessary, use BACK of this sheet)
Name of Plugging Contractor Wilson Inc.
Address Great Bend, Kansas

STATE OF KANSAS, COUNTY OF BARTON, ss.
Jim Robinson (employee of owner) or (owner or operator) of the above-described well, being first duly sworn on oath, says: That I have knowledge of the facts, statements, and matters herein contained and the log of the above-described well as filed and that the same are true and correct. So help me God.
(Signature) Jim Robinson
Box 765 Gt. Bend, Kansas (Address)

SUBSCRIBED AND SWORN TO before me this 11 day of October, 19 56

My commission expires September 21, 1960
Yvonne Adams Notary Public.

PLUGGING
FILE SEC 24 T. 20 R. 12W
BOOK PAGE 100 LINE 16

STATE CORPORATION COMMISSION
OCT 12 1956
CONSERVATION DIVISION
Wichita, Kansas
10-12-1956