

15.009.21954.0000


STATE OF KANSAS  
STATE CORPORATION COMMISSION

WELL PLUGGING RECORD

Give All Information Completely.  
Make Required Affidavit  
Mail or Deliver Report to  
Conservation Division  
State Corporation Comm.  
245 North Water  
Wichita, KS 67202

Barton County. Sec. 23 Twp. 20 Rge. 12W E/W  
Location as "NE/CNW $\frac{1}{2}$ /SW $\frac{1}{2}$ " or footage from lines  
CW/2 SW SE

Lease Owner Poor Boy Corporation  
Lease Name Biege Well No. 2  
Office Address RR 2 Ellinwood, Kansas 67526  
Character of Well (Completed as Oil, Gas or Dry Hole) \_\_\_\_\_

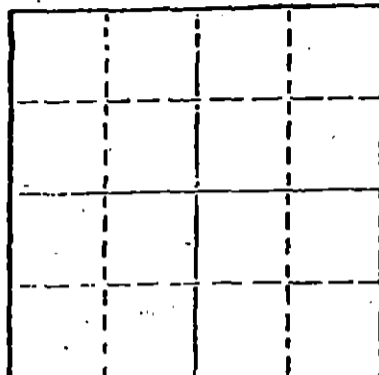

Locate well correctly on above  
Section Plat

Date Well completed February 24, 1980  
Application for plugging filed February 24, 1980  
Application for plugging approved February 24, 1980  
Plugging commenced February 24, 1980  
Plugging completed February 24, 1980  
Reason for abandonment of well or producing formation \_\_\_\_\_

If a producing well is abandoned, date of last production  
\_\_\_\_\_ 19\_\_\_\_

Was permission obtained from the Conservation Division or  
its agents before plugging was commenced? yes

Name of Conservation Agent who supervised plugging of this well Duane Rankin  
Producing formation \_\_\_\_\_ Depth to top \_\_\_\_\_ Bottom \_\_\_\_\_ Total Depth of Well \_\_\_\_\_  
Show depth and thickness of all water, oil and gas formations.

OIL, GAS OR WATER RECORDS

CASING RECORD

FORMATION	CONTENT	FROM	TO	SIZE	PUT IN	PULLED OUT
				8 5/8	257	

Describe in detail the manner in which the well was plugged, indicating where the mud fluid  
was placed and the method or methods used in introducing it into the hold. If cement or other  
plugs were used, state the character of same and depth placed, from \_\_\_\_\_ feet to  
\_\_\_\_\_ feet for each plug set.

35 sx. @ 420'  
plug & 10 sx. @ 40'  
5 sx. in the rathole

2-27-1980

RECEIVED  
STATE CORPORATION COMMISSION

FEB 27 1980

CONSERVATION DIVISION  
Wichita, Kansas

(If additional description is necessary, use BACK of this sheet)

Name of Plugging Contractor Woodman & Iannitti Drilling Co.

STATE OF KANSAS COUNTY OF SEDGWICK, ss.  
K. T. Woodman (employee of owner) or (owner or operator  
of the above-described well, being first duly sworn on oath, says: That I have knowledge of  
the facts, statements, and matters herein contained and the log of the above-described well  
as filed and that the same are true and correct. So help me God.

(Signature) K. T. Woodman

1008 Douglas Bldg. 104 S. Broadway  
(Address)

SUBSCRIBED AND SWORN TO before me this \_\_\_\_\_ day of \_\_\_\_\_, 19 79

My commission expires Feb. 11, 1984

Justina Chamberlain  
Notary Public.

Notary Public.

15.009.21854.0000

K. T. WOODMAN  
RES. PHONE 733-0418  
OFF. PHONE 265-7650  
WICHITA, KANSAS

D. J. IANNITTI  
PHONE 792-2921  
GREAT BEND, KANSAS

# WOODMAN & IANNITTI DRILLING COMPANY

*Rotary Drilling Contractors*

1008 DOUGLAS BUILDING  
104 S. BROADWAY  
WICHITA, KANSAS 67202

February 26, 1980

Company;	Poor Boy Corporation
Farm;	#2 Biege
Location;	CW/2 SW SE
Section;	23-20-12W
County;	Barton
Contractor;	Woodman & Iannitti Drilling Co.
Total Depth;	3387
Comm;	February 19, 1980
Compl;	February 24, 1980
Casing;	8 5/8 @ 257' w/225 sx
Production;	D & A

Figures Indicate Bottom Of Formation

70	Sand
145	Sand
170	Shale
190	Sand
262	Redbed
582	Redbed
598	Anhydrite
861	Redbed
990	Shale
1660	Shale
1920	Shale
2130	Shale
2430	Shale
2670	Shale & lime
2860	Shale & lime
3050	Shale & lime
3210	Lime & shale
3325	Kansas City
3387	Total Depth

RECEIVED  
STATE CORPORATION COMMISSION

FEB 27 1980

I certify the above to be a true and correct copy of the drillers log to the best of my knowledge and belief.

CONSERVATION DIVISION  
OF THE  
STATE OF KANSAS  
Wichita, Kansas

Woodman & Iannitti Drilling Co.

*K. T. Woodman*

K. T. Woodman