


STATE OF KANSAS  
STATE CORPORATION COMMISSION

WELL PLUGGING RECORD

Give All Information Completely  
Make Required Affidavit  
Mail or Deliver Report to:  
Conservation Division  
State Corporation Commission  
800 Bittling Building  
Wichita, Kansas

Barton County, Sec. 23 Twp. 20 Rge. (E) 12 (W)  
Location as "NE/CNW $\frac{1}{4}$ SW $\frac{1}{4}$ " or footage from lines SE SE NE  
Lease Owner Murfin Drilling Co., et al  
Lease Name Koch Well No. 1  
Office Address 910 Union Natl. Bank Bldg., Wichita, Ks.  
Character of Well (completed as Oil, Gas or Dry Hole) Dry Hole  
Date well completed 5-28-52 19  
Application for plugging filed 5-28-52 19  
Application for plugging approved 5-28-52 19  
Plugging commenced 5-28-52 19  
Plugging completed 5-28-52 19  
Reason for abandonment of well or producing formation

NORTH

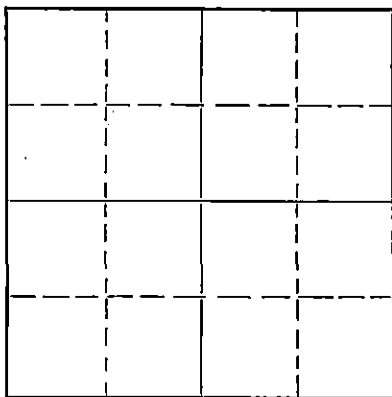

Locate well correctly on above  
Section Plat

If a producing well is abandoned, date of last production 19  
Was permission obtained from the Conservation Division or its agents before plugging was commenced? Yes

Name of Conservation Agent who supervised plugging of this well C. D. Stough  
Producing formation Depth to top Bottom Total Depth of Well 3424 Feet  
Show depth and thickness of all water, oil and gas formations.

OIL, GAS OR WATER RECORDS

CASING RECORD

Formation	Content	From	To	Size	Put In	Pulled Out
				8 5/8	257	0

Describe in detail the manner in which the well was plugged, indicating where the mud fluid was placed and the method or methods used in introducing it into the hole. If cement or other plugs were used, state the character of same and depth placed, from feet to feet for each plug set.

Filled hole to 240', set 1st plug. Mixed and displaced 20 sacks  
cement through drill pipe. Filled to 35', set 2nd plug. Mixed  
and displaced 10 sacks cement.

(If additional description is necessary, use BACK of this sheet)

Correspondence regarding this well should be addressed to Murfin Drilling Co.  
Address 910 Union Natl. Bank Bldg., Wichita, Ks.

STATE OF Kansas, COUNTY OF Sedgwick, ss.  
W. R. Murfin (employee of owner) or (owner or operator) of the above-described well,  
being first duly sworn on oath, says: That I have knowledge of the facts, statements, and matters herein contained and the log of the above-described well as filed and that the same are true and correct. So help me God.

(Signature) W.R. Murfin  
Wichita, Kansas (Address)

SUBSCRIBED AND SWORN to before me this 27th day of June, 1952.

Helen Horine Notary Public.

My commission expires 6-4-55

PLUGGING  
FILE SEC 23 T 20 R 12  
PAGE 19 LINE 45

RECEIVED  
STATE CORPORATION COMMISSION  
JUN 28 1952  
6-28-1952  
CONSERVATION DIVISION  
Wichita, Kansas

# WELL LOG


15.009.05689.0000

COMPANY Murfin Drilling Co., et al  
FARM Koch NO. 1

SEC. 23 T. 20 R. 12W  
LOC. SE SE NE

TOTAL DEPTH 3424  
COMM. 5-18-52 COMP. 5-28-52  
SHOT OR TREATED  
CONTRACTOR Murfin Drilling Co.  
ISSUED

COUNTY Barton  
KANSAS

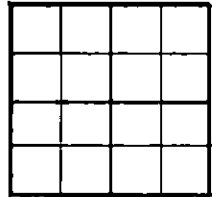

CASING  
20 10  
15 8 257  
12 6  
13 5

ELEVATION

PRODUCTION Dry

FIGURES INDICATE BOTTOM OF FORMATIONS

170 sand-shale  
244 shale-red bed  
593 red bed  
630 Anhydrite  
1060 red bed-shale-shells  
1390 salt-shells  
1685 lime-shale  
1940 lime  
2905 lime-shale  
3000 lime  
3110 lime-shale  
3357 lime  
3388 lime-shale  
3424 lime

RECEIVED  
STATE CORPORATION COMMISSION

JUN 23 1952

CONSERVATION DIVISION,  
Wichita, Kansas

State of Kansas  
County of Sedgwick

ss:

I, Fred Murfin of the Murfin Drilling Company

upon oath state that the above and foregoing is a true and correct copy of the log of the Koch #1 well.

PLUGGING  
FILE SEC-23 T. 20 R. 12W  
PAGE 19 LINE 45

Fred Murfin

Subscribed and sworn to before me this 27th day of June 1952

My Commission Expires: 6-4-55

Helen Horine  
NOTARY PUBLIC