


WELL PLUGGING RECORD

Give All Information Completely
Make Required Affidavit
Mail or Deliver Report to:
Conservation Division
State Corporation Commission
800 Biting Building
Wichita, Kansas

Barton County, Sec 22 Twp 20S Rge. (E) 12 (W)

Location as "NE/CNW&SW" or footage from lines SW/4 SE/4 SE/4
Lease Owner Heathman-Seeligson Drilling Co.
Lease Name MILLER Well No. 1
Office Address 254 No. Washington, Wichita, Kansas
Character of Well (completed as Oil, Gas or Dry Hole) dry hole
Date well completed 6-4-54 19
Application for plugging filed 6-4-54 19
Application for plugging approved 6-4-54 19
Plugging commenced 6-4-54 19
Plugging completed 6-4-54 19
Reason for abandonment of well or producing formation ----

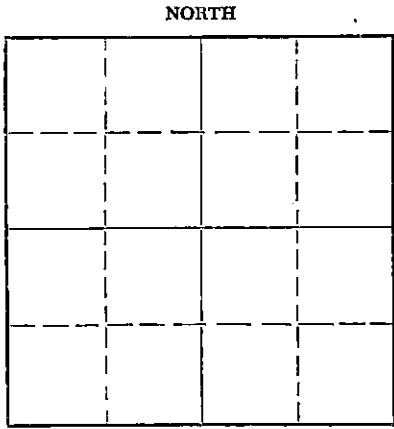

Locate well correctly on above Section Plat

If a producing well is abandoned, date of last production ---- 19
Was permission obtained from the Conservation Division or its agents before plugging was commenced? yes

Name of Conservation Agent who supervised plugging of this well C.D. Stough, Great Bend, Kansas
Producing formation -- Depth to top -- Bottom -- Total Depth of Well 3540 Feet
Show depth and thickness of all water, oil and gas formations.

OIL, GAS OR WATER RECORDS

CASING RECORD

FORMATION	CONTENT	FROM	TO	SIZE	PUT IN	PULLED OUT
none	--	--	--	8-5/8" surf. csg.	" 260'	
				w/225 sax Cement and		
				3 sax. Cal. Chlor.		none

Describe in detail the manner in which the well was plugged, indicating where the mud fluid was placed and the method or methods used in introducing it into the hole. If cement or other plugs were used, state the character of same and depth placed, from _____ feet to _____ feet for each plug set.

Filled hole with heavy mud to 250'; set plug of 1/3 sack hulls and 20 sacks cement; filled to 35' w/heavy mud; set plug of 1/3 sack hulls and 10 sacks cement. Bottom of cellar reached.

RECEIVED
STATE CORPORATION COMMISSION

JUN 12 1954

CONSERVATION DIVISION
WICHITA, KANSAS

6-12-1954

(If additional description is necessary, use BACK of this sheet)

Name of Plugging Contractor Heathman-Seeligson Drilling Co.
Address 254 No. Washington, Wichita 7, Kansas

STATE OF Kansas, COUNTY OF Sedgwick, ss.
H. D. Shreve (employee of owner) or (owner or operator) of the above-described well, being first duly sworn on oath, says: That I have knowledge of the facts, statements, and matters herein contained and the log of the above-described well as filed and that the same are true and correct. So help me God. HEATHMAN-SEELIGSON DRILLING CO.

By: [Signature]
(Signature) 254 No. Washington, Wichita 7 Kansas
(Address)

SUBSCRIBED AND SWORN to before me this 10th day of June, 19 54

My commission expires June 28, 1956

[Signature] Notary Public.

PLUGGING
FILE SEC 22 T 20 R 12W
BOOK PAGE 40 LINE 5

DRILLERS' LOG

Name: #1 Miller Spudded: 5-25-54
 Location: SW/4 SE4 SE/4 Sec.22-20S-12W Rotary Completed: 6-4-54
 Barton County, Kansas
 Operator: Heathman-Seeligson Drilling Co. Total Depth: 3450'
 Contractor: Heathman-Seeligson Drilling Co. Elevation: 1834 gr.
 1837 DF
 1840 KB
 Surface Casing: 8-5/8" spiral weld (7 jts.) cemented
 @ 260' w/225 sacks cement and 3 sacks
 Cal.Chloride. Cement Circulated.
 Oil String: None run - Dry and abandoned.

GEOLOGICAL TOPS (KB)

Anhydrite	627 (-1213)	drillers
Heebner	3023 (-1183)	
Br.Lime	3148 (-1308)	
Lansing-K.C.	3164 (-1324)	
Penn.Conglom.	3392 (-1552)	
Arbuckle	3439 (-1599)	
Total Depth	3450 (-1610)	

DRILL STEM TESTS:

#1 DST 3179-3202 - open 1 hour, recov.15' mud, BHP 0#
 #2 DST 3288 to 3312 - open 1 hour, recovered 5ft. mud, BHP 0#

L O G

(Formation depth indicated.)

Sand	0 to	210
Shale		260
Red Bed		627
Anhydrite		660
Shale and shells		860
Shale and shells		1500
Lime and shale		2290
Shale and lime shells		2545
Lime and shale		2791
Broken lime		2875
Lime		3030
Lime and shale		3130
Lime		3450
Total Depth		3450

The undersigned, H. D. Shreve, hereby certifies that the above log is a true and correct log of the formations encountered in drilling the above noted well as reflected by the Daily Drilling Reports.

HEATHMAN-SEELIGSON DRILLING CO.

By: 

Subscribed and sworn to before me
 this 10th day of June 1954.


 Notary Public

My commission expires: June 28, 1956.

RECEIVED
 STATE CORPORATION COMMISSION

JUN 12 1954

PLUGGING
 FILE SEC 22-20-12W
 BOOK PAGE 40 LINE 5
 CONSERVATION DIVISION
 Wichita, Kansas