


WELL PLUGGING RECORD

Give All Information Completely
Make Required Affidavit
Mail or Deliver Report to:
Conservation Division
State Corporation Commission
300 Bitting Building
Wichita, Kansas

NORTH

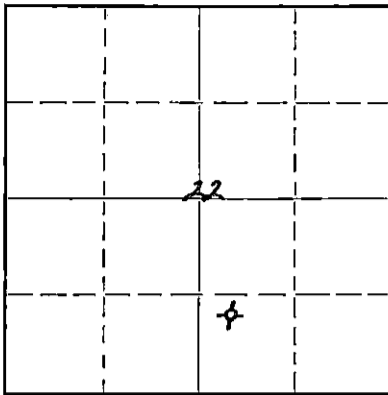

Locate well correctly on above
Section Plat

Barton County. Sec. 22 Twp. 20S Rge. 12 (E) W (W)
Location as "NE/CNW $\frac{1}{4}$ SW $\frac{1}{4}$ " or footage from lines NW SW SE
Lease Owner Alpine Oil & Royalty Co., - North American
Lease Name Miller Well No. 1
Office Address 300 Bitting Bldg., Wichita, Kansas
Character of Well (completed as Oil, Gas or Dry Hole) Dry Hole (hole caved)
Date well completed March 16th 1950
Application for plugging filed March 31st 1950
Application for plugging approved April 1st, 1950
Plugging commenced April 1st, 1950
Plugging completed April 1st, 1950
Reason for abandonment of well or producing formation Hole caved badly while
drilling in well with cable tools.
If a producing well is abandoned, date of last production 19
Was permission obtained from the Conservation Division or its agents before plugging was com-
menced? Yes.

Name of Conservation Agent who supervised plugging of this well C. D. Stough
Producing formation Arbuckle Depth to top 3388 Bottom 3429 Total Depth of Well 3429 Feet
Show depth and thickness of all water, oil and gas formations.

OIL, GAS OR WATER RECORDS

CASING RECORD

Formation	Content	From	To	Size	Put In	Pulled Out
				8 5/8"	251	Cemented

Describe in detail the manner in which the well was plugged, indicating where the mud fluid was placed and the method or methods used in introducing it into the hole. If cement or other plugs were used, state the character of same and depth placed, from _____ feet to _____ feet for each plug set.

Sand 3419 to 3380 ft.
5 Sacks cement 3380 to 3350 ft.
Mudded 3350 to 260 ft.
Rock bridge 260 to 250 ft.
15 Sacks cement, 250 to 210 ft.
Mud 210' to 20 ft.
Rock Bridge 20 ft. to 15 ft.
10 sacks cement 15 ft. to cellar.

APR 5 1950
4-5-1950
CONSERVATION DIVISION
WICHITA

(If additional description is necessary, use BACK of this sheet)
Correspondence regarding this well should be addressed to Alpine Oil & Royalty Co., Inc.
Address 300 Bitting Bldg., Wichita, Kansas

STATE OF Kansas COUNTY OF Sedgwick, ss.
Thomas M. McCaul (employee of owner) or (owner or operator) of the above-described well,
being first duly sworn on oath, says: That I have knowledge of the facts, statements, and matters herein contained and the log of the above-
described well as filed and that the same are true and correct. So help me God.
(Signature) Thomas M. McCaul
300 Bitting Bldg., Wichita, Kansas
(Address)

SUBSCRIBED AND SWORN to before me this 3rd day of April, 19 50.
Lawrence Allen
Notary Public.

My commission expires August 8, 1953.

22-7877-8 4-49-10M
PLUGGING
FILE SEC 22 T 20 R 12
BOOK PAGE 145 LINE 27

WELL LOG

Alpine Oil & Royalty Co., Inc., and
North American Producing Company

Commenced: 2-13-50
Completed: 2-21-50
Production:

Contractor: Quaker Drilling Co., Inc.

Elevation: 1831 R.B.

Miller No. 1
NW SW SE Sec. 22-20S-12W
Barton County, Kansas

Hole abandoned and
plugged because of
bad cave-ins.

Casing Record:

Set 8 5/8" at 251 feet with 200 sacks cement.

(Figures Indicate Bottom of Formations)

<u>FORMATION</u>	<u>DEPTH</u>	<u>FORMATION TOPS</u>	
Surface Clay & Sand	251	Heebneer Shale	3019 -1188
Shale & Red Bed	605	Brown Lime	3143 -1312
Anhydrite	635	White Lansing	3160 -1329
Shale and Shells	675	Arbuckle	3388 -1557
Shale and Lime	2700	Set 5 1/2" @	3389 -1558
Lime	2785	Total Depth (Rotary)	3390 -1559
Lime & Shale	3388	Total Depth (Cable)	3429 -1598
Dolomite	3390		

I hereby certify that the above is a true and correct copy of Driller's Log of well drilled in the NW SW SE of Section 22, Township 20 South, Range 12 West, Barton County, Kansas.

ALPINE OIL & ROYALTY CO., INC.

By: Thomas M. M. Paul
President

APR 5 1950
STATE OF KANSAS
COMMISSIONER OF GEOLOGY

Subscribed and sworn to before me this 3rd day of April, 1950.

Lawrence Allen
Notary Public

My commission expires: August 8, 1953.

PLUGGING
FILE SEC 22 T 20 R 14 W
BOOK PAGE 145 LIKE 27