


STATE OF KANSAS
STATE CORPORATION COMMISSION

Give All Information Completely
Make Required Affidavit
Mail or Deliver Report to:
Conservation Division
State Corporation Commission
211 No. Broadway
Wichita, Kansas

15.009.15575.0000

WELL PLUGGING RECORD

NORTH

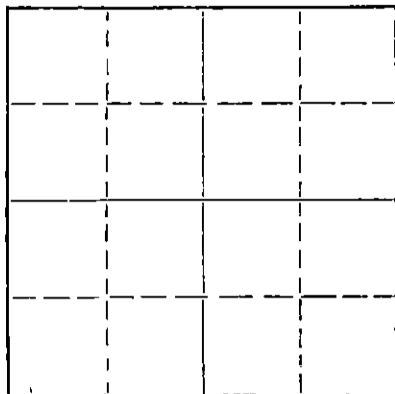

Locate well correctly on above
Section Plat

Barton County. Sec. 22 Twp. 20S Rge. 12W (E) (W)
Location as "NE/CNW%SW%" or footage from lines SW SW NE
Lease Owner Alpine Oil & Royalty Co., Inc.
Lease Name Woodmansee Well No. 1
Office Address 1100 Bitting Building, Wichita, Kansas
Character of Well (completed as Oil, Gas or Dry Hole) oil
Date well completed July 12, 1957 19
Application for plugging filed May 5, 1958 19
Application for plugging approved May 5, 1958 19
Plugging commenced May 5, 1958 19
Plugging completed May 7, 1958 19
Reason for abandonment of well or producing formation Non-productive in
commercial quantities
If a producing well is abandoned, date of last production: February 23, 1958
Was permission obtained from the Conservation Division or its agents before plugging was com-
menced? Yes

Name of Conservation Agent who supervised plugging of this well Donald Truan
Producing formation Arbuckle Depth to top 3381 Bottom _____ Total Depth of Well 3440 Feet
Show depth and thickness of all water, oil and gas formations.

OIL, GAS OR WATER RECORDS

CASING RECORD

FORMATION	CONTENT	FROM	TO	SIZE	PUT IN	PULLED OUT
				8 5/8"	240'	none
				5 1/2"	3440	2690.66

Describe in detail the manner in which the well was plugged, indicating where the mud fluid was placed and the method or methods used in introducing it into the hole. If cement or other plugs were used, state the character of same and depth placed, from _____ feet to _____ feet for each plug set.

Sanded to 3400' - dumped 5 sacks cement - mudded hole
tried to bail fluid down - wouldn't bail - set plug at 240'
set 10' rock bridge on top of plug - dumped 25 sacks
cement with bailer - bailed fluid out of hole - waited to
see if plug was holding - no fluid came in through plug
mudded to 40' - set 10' rock bridge - dumped 10
sacks cement.

RECEIVED
STATE CORPORATION COMMISSION

MAY 22 1958

CONSERVATION DIVISION
Wichita, Kansas

5-22-1958

(If additional description is necessary, use BACK of this sheet)

Name of Plugging Contractor R & D Casing Pulling Company
Address Box 569 Ellinwood, Kansas

STATE OF Kansas, COUNTY OF Sedgwick, ss.
Thomas M. McCaul (employee of owner) or (owner or operator) of the above-described

well, being first duly sworn on oath, says: That I have knowledge of the facts, statements, and matters herein contained and the log of the above-described well as filed and that the same are true and correct. So help me God.

(Signature) Thomas M. McCaul

1100 Bitting Building, Wichita, Kansas
(Address)

SUBSCRIBED AND SWORN TO before me this 21st day of May, 1958

My commission expires August 10, 1961

Virginia Mundell
Notary Public.

PLUGGING
FILE SEC. 22 T. 20 R. 12W
BOOK PAGE 98 LINE 23

15.009.15575.0000

WELL LOG

ALPINE OIL & ROYALTY CO., INC.

Commenced: June 10, 1957

Contractor: Quaker Drilling Co., Inc.

Completed: June 19, 1957

Woodmansee No. 1
SW SW NE Section 22-20S-12W
Barton County, Kansas

Elevation: 1825 K. B.

Casing Record:

Set 8 5/8 inch casing at 240 feet with 225 sacks cement
Set 5 1/2 inch casing at 3440 feet with 125 sacks cement

(Figures Indicate the Bottom of the Formation)

<u>FORMATION</u>	<u>DEPTH</u>	<u>FORMATION TOPS</u>
Sand	170	Heebner 3002 -1177
Shale	180	Brown Lime 3126 -1301
Shale and Shells	240	Lansing 3144 -1319
Shale and Red Bed	608	Base of Kansas
Anhydrite	628	City 3365 -1540
Shale and Shells	1480	Arbuckle 3381 -1556
Shale and Sandy Lime	1805	Rotary Total Depth 3440 -1615
Lime and Shale	1930	
Shale and Lime	2078	
Shale	2295	
Shale and Lime	2800	
Lime	2876	
Shale and Lime	3050	
Shale	3126	
Lime and Shale	3133	
Shale and Lime	3195	
Lime	3220	
Lime and Shale	3290	
Shale and Lime	3300	
Lime	3375	
Shale and Lime	3440	

RECEIVED
STATE CORPORATION COMMISSION

MAY 22 1958

CONSERVATION DIVISION
Wichita, Kansas

We hereby certify the foregoing to be a true and correct copy of the Driller's Log of the well drilled in the SW SW NE of Section 22, Township 20 South, Range 12 West, Barton County, Kansas.

QUAKER DRILLING CO., INC.

By: *Thomas M. McCaul*
Thomas M. McCaul, President

SUBSCRIBED AND SWORN TO before me, a Notary Public, in and for Sedgwick County, Kansas this 9th day of July, 1957.

Virginia Mandell
Virginia Mandell, Notary Public

MY COMMISSION EXPIRES:
August 10, 1957

PLUGGING
FILE SEC. 22 T. 20 R. 12W
BOOK PAGE 98 LINE 23