


WELL PLUGGING RECORD

Give All Information Completely
Make Required Affidavit
Mail or Deliver Report to:
Conservation Division
State Corporation Commission
800 Bitting Building
Wichita, Kansas

Barton County, Sec. 17 Twp. 20S Rge. ~~X~~12 (W) NW SE SE

Location as "NE/CNW/SW" or footage from lines _____
Lease Owner Alpine Oil & Royalty Co., Inc.
Lease Name CHRISTIANSEN Well No. 1
Office Address 1100 Bitting Bldg., Wichita, Kansas
Character of Well (completed as Oil, Gas or Dry Hole) Dry Hole
Date well completed July 28, 19 53
Application for plugging filed July 28, 19 53
Application for plugging approved July 28, 19 53
Plugging commenced July 28, 19 53
Plugging completed July 28, 19 53
Reason for abandonment of well or producing formation not productive
If a producing well is abandoned, date of last production _____ 19 _____
Was permission obtained from the Conservation Division or its agents before plugging was commenced? YES

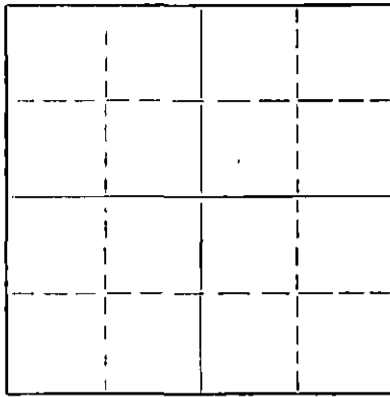

Locate well correctly on above Section Plat

Name of Conservation Agent who supervised plugging of this well C. D. Stough
Producing formation _____ Depth to top _____ Bottom _____ Total Depth of Well 3468 Feet
Show depth and thickness of all water, oil and gas formations.

OIL, GAS OR WATER RECORDS

CASING RECORD

FORMATION	CONTENT	FROM	TO	SIZE	PUT IN	PULLED OUT
				10 3/4"	210'	cemented

Describe in detail the manner in which the well was plugged, indicating where the mud fluid was placed and the method or methods used in introducing it into the hole. If cement or other plugs were used, state the character of same and depth placed, from _____ feet to _____ feet for each plug set.

Filled hole with heavy mud.
Bottom plug down to 198',
1/2 sack Hulls on top of plug.
20 sacks cement through drill pipe on top of plug. Top plug 40'. 10 sacks cement to top of surface pipe.

(If additional description is necessary, use BACK of this sheet)
Name of Plugging Contractor QUAKER DRILLING CO., INC.
Address 1100 Bitting Bldg., Wichita, Kansas

STATE OF KANSAS COUNTY OF SEDGWICK, ss.
Thomas M. McCaul ~~X~~ (owner or operator) of the above-described well, being first duly sworn on oath, says: That I have knowledge of the facts, statements, and matters herein contained and the log of the above-described well as filed and that the same are true and correct. So help me God.

(Signature) Thomas M. McCaul
1100 Bitting Bldg., Wichita, Kansas
(Address)

SUBSCRIBED AND SWORN TO before me this 30th day of July 19 53

My commission expires Sept. 14, 1953

Robert Bell
STATE CORPORATION COMMISSION Notary Public.

24-2675-S 2-52-20M

PLUGGING
FILED SEC 17 T 20 R 12W
BOOK PAGE 118 LINE 15

JUL 30 1953
CONSERVATION DIVISION
Wichita, Kansas
7-30-1953

15.009.00108.0000

WELL LOG

ALPINE OIL & ROYALTY CO., INC.

Commenced: 7-17-53

Contractor: Quaker Drilling Co., Inc.

Completed: 7-28-53

Christiansen #1
NW SE SE Sec. 17-20S-12W
Barton County, Kansas

Elevation: 1845 R.B.

Production: D & A

Casing Record:

Set 210' of 10 3/4" casing
w/ 200 sacks cement

(Figures Indicate Bottom of Formations)

<u>FORMATION</u>	<u>DEPTH</u>	<u>FORMATION TOPS</u>
Sand	140	Anhydrite 640 +1205
Shale & Shells	200	Heebner 3049 -1204
Sand & Shale	225	Brown Lime 3173 -1328
Red Bed	380	Lansing 3192 -1347
Red Bed & Shale	640	Conglomerate 3430 -1585
Anhydrite	670	Arbuckle none
Shale & Shells	1370	
Lime & Shale	1470	Total Depth (R) 3468 -1623
Lime	1505	
Lime & Shale	1735	
Lime-Shale-Sand	1840	
Lime & Shale	1905	
Shale	2000	
Lime & Shale	2205	
Shale	2315	
Lime & Shale	2985	
Lime	3095	
Lime & Shale	3155	
Shale	3176	
Lime	3245	
Lime & Shale	3385	
Lime	3450	
Lime & Shale	3468	

I hereby certify that the above is a true and correct copy of Drillers Log of well drilled in the NW SE SE of Section 17, Township 20 South, Range 12 West, Barton County, Kansas.

ALPINE OIL & ROYALTY CO., INC.

By: *Thomas M. M. Cavel*

Subscribed and sworn to before me this 30th day of July, 1953.

Wesley Bell
Notary Public
STATE CORPORATION COMMISSIONER

My commission expires: Sept. 14, 1953

PLUGGING
WELL SEC 17 T20S R 12W
BOOK PAGE 118 LINE 15

JUL 30 1953
CONSERVATION DIVISION
Wichita Kansas