

STATE OF KANSAS
STATE CORPORATION COMMISSION


WELL PLUGGING RECORD

Give All Information Completely
Make Required Affidavit
Mail or Deliver Report to:
Conservation Division
State Corporation Commission
800 Bitting Building
Wichita, Kansas

OR
FORMATION PLUGGING RECORD

Strike out upper line
when reporting plug-
ging of formations.

Barton County. Sec. 26 Twp. 20 Rge. 12 (E) (W)
Location as "NE $\frac{1}{4}$ NW $\frac{1}{4}$ SW $\frac{1}{4}$ " or footage from lines SW NE SE
Lease Owner Alpine Oil & Royalty Co., Inc.
Lease Name Anna Schrepel Well No. 1
Office Address 300 Bitting Bldg., Wichita, Kansas
Character of Well (completed as Oil, Gas or Dry Hole) Dry Hole
Date well completed July 15th 19 49
Application for plugging filed July 15th 19 49
Application for plugging approved July 15th 19 49
Plugging commenced July 15th 19 49
Plugging completed July 15th 19 49
Reason for abandonment of well or producing formation.....

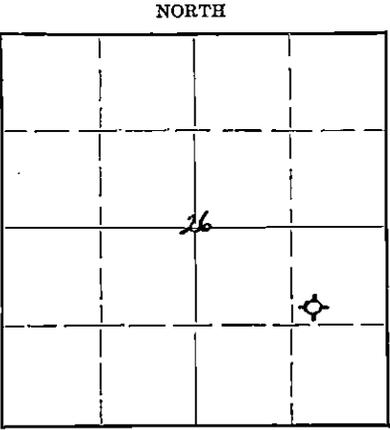

Locate well correctly on above
Section Plat

If a producing well is abandoned, date of last production.....19.....
Was permission obtained from the Conservation Division or its agents before plugging was com-
menced? Yes.

Name of Conservation Agent who supervised plugging of this well C. D. Stough
Producing formation..... Depth to top..... Bottom..... Total Depth of Well 3426 Feet
Show depth and thickness of all water, oil and gas formations.

OIL, GAS OR WATER RECORDS

CASING RECORD

Formation	Content	From	To	Size	Put In	Pulled Out
				8 5/8"	253'	Cemented

Describe in detail the manner in which the well was plugged, indicating where the mud fluid was placed and the method or methods used in introducing it into the hole. If cement or other plugs were used, state the character of same and depth placed, from.....feet to.....feet for each plug set.

Heavy mud from 3426' to 253'. Solid plug and 15 sacks cement through drill pipe. Heavy mud to 30' and 10 sacks cement to bottom of cellar.

7-18-1949

(If additional description is necessary, use BACK of this sheet)

Correspondence regarding this well should be addressed to Alpine Oil & Royalty Co., Inc.
Address 300 Bitting Bldg., Wichita, Kansas


STATE OF KANSAS, COUNTY OF SEDGWICK, ss.
Dwight J. Wilson (employee of owner) or (owner or operator) of the above-described well,
being first duly sworn on oath, says: That I have knowledge of the facts, statements, and matters herein contained and the log of the above-described well as filed and that the same are true and correct. So help me God.

(Signature) Dwight J. Wilson
Secretary-Treasurer
300 Bitting Bldg., Wichita, Kansas
(Address)

SUBSCRIBED AND SWORN to before me this 18th day of July, 19 49

My commission expires September 14, 1949.

Notary Public.

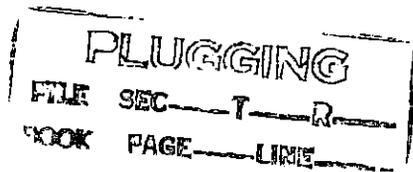

WELL LOG

Alpine Oil & Royalty Co., Inc.

Elevation: 1831

Contractor: Quaker Drilling Co., Inc.,

Commenced: 7-6-49

Completed: 7-15-49

Schrepel No. 1

Production: Dry & Abandoned.

SW NE SE Sec. 26-20-12W.

Barton County, Kansas

Casing Record:

(8 5/8" 253' with 220 sacks cement.)

(Figures Indicate Bottom of Formations)

<u>FORMATION</u>	<u>DEPTH</u>	<u>FORMATION TOPS</u>	
Surface Clay & Sand	195	Hoobner Shale	3018 -1137
Shale & Lime Shells	253	Brown Lime	3119 -1238
Red Bed & Shale	602	White Lansing	3138 -1307
Anhydrite	632	Arbuckle	3116 -1585
Shale & Shells	1185	Total Depth (Rotary)	3126 -1595
Shale & Lime	1635		
Lime	1765		
Lime & Shale	2025		
Lime	2890		
Lime & Shale	3230		

RECEIVED

Geological Div.
 JUL 22 1949
 STATE DEPARTMENT OF
 COMMISSION
 KANSAS

I hereby certify that the above is a true and correct copy of Drillers Log of well drilled in the SW NE SE of Section 26, Township 20 South, Range 12 West, Barton County, Kansas.

ALPINE OIL & ROYALTY CO., INC.

By Thomas M. McCull

Subscribed and sworn to before me this 18th day of July, 1949.

Vashti Bell
 Notary Public

My Commission Expires: September 14, 1949.

15.009.05668.0000

WELL LOG

Alpine Oil & Royalty Co., Inc.

Elevation: 1831

Contractor: Quaker Drilling Co., Inc.,

Commenced: 7-6-49

Schrepel No. 1
SW NE SE Sec. 26-20-12W
Barton County, Kansas

Completed: 7-15-49

Production: Dry & Abandoned.

Casing Record:

(8 5/8" 253' with 220 sacks cement.)

(Figures Indicate Bottom of Formations)

<u>FORMATION</u>	<u>DEPTH</u>	<u>FORMATION TOPS</u>	
Surface Clay & Sand	195	Hoebner Shale	3018 -1137
Shale & Lime Shells	253	Brown Lime	3119 -1288
Red Sod & Shale	602	White Lansing	3138 -1307
Anhydrite	632	Arbuckle	3146 -1585
Shale & Shells	1185	Total Depth (Rotary)	3126 -1595
Shale & Lime	1635		
Lime	1765		
Lime & Shale	2825		
Lime	2890		
Lime & Shale	3230		

I hereby certify that the above is a true and correct copy of Drillers Log of well drilled in the SW NE SE of Section 26, Township 20 South, Range 12 West, Barton County, Kansas.

[Faint stamp]

JUL 18 1949
 STATE CORPORATION COMMISSION
 KANSAS

ALPINE OIL & ROYALTY CO., INC.
 By Thomas M. McPaul

Subscribed and sworn to before me this 18th day of July, 1949.

Yashti Bell
 Notary Public

My Commission Expires: September 14, 1949.

PLUGGING
 FILE SEC T R
 BOOK PAGE LINE