

STATE OF KANSAS
STATE CORPORATION COMMISSION

WELL PLUGGING RECORD

Give All Information Completely
Make Required Affidavit
Mail or Deliver Report to:
Conservation Division
State Corporation Commission
800 Bittling Building
Wichita, Kansas

FORMATION PLUGGING RECORD

Strike out upper line
when reporting plug-
ging off formations.

Barton County. Sec. 26 Twp. 20S Rge. 12 (E) (W)

Location as "NE $\frac{1}{4}$ NW $\frac{1}{4}$ SW $\frac{1}{4}$ " or footage from lines 994' f/N, 660' f/W lines

Lease Owner Phillips Petroleum Company

Lease Name Schrepel Well No. 1

Office Address Great Bend, Kansas

Character of Well (completed as Oil, Gas or Dry Hole) Dry hole

Date well completed October 3, 1949

Application for plugging filed October 15, 1949

Application for plugging approved October 15, 1949


Plugging commenced October 17, 1949

Plugging completed October 19, 1949

Reason for abandonment of well or producing formation Dry hole

If a producing well is abandoned, date of last production — 19—

Was permission obtained from the Conservation Division or its agents before plugging was commenced? Yes

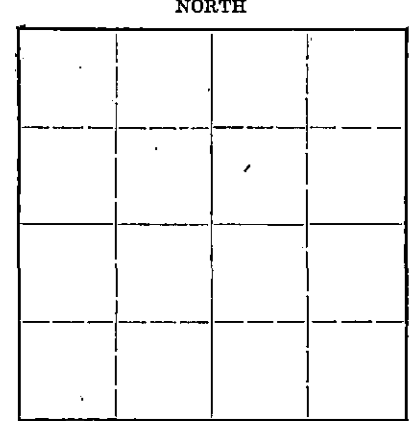

Locate well correctly on above
Section Plat

Name of Conservation Agent who supervised plugging of this well C. D. Stough

Producing formation Arbuckle lime Depth to top 3383 Bottom 3452 Total Depth of Well 3452 Feet

Show depth and thickness of all water, oil and gas formations.

OIL, GAS OR WATER RECORDS

CASING RECORD

Formation	Content	From	To	Size	Put In	Pulled Out
Topeka	Dry	2742				
Heebner	"	3008		8-5/8"	266'	None
Toronto	"	3022				
Brown lime	"	3132		5-1/2"	3405'	2707'
L.K.C.	"	3150				
Arbuckle	"	3383				

Describe in detail the manner in which the well was plugged, indicating where the mud fluid was placed and the method or methods used in introducing it into the hold. If cement or other plugs were used, state the character of same and depth placed, from _____ feet to _____ feet for each plug set.

Plugged back with cement 3452 to 3128'.
Rocked hole from 3128' to 3015'. Dumped
5 sacks cement. Mudded hole to 272';
set Rock Bridge and dumped 15 sacks cement;
mudded hole to 30' and dumped 10 sacks cement to cap.

Plugging completed 10-19-49

RECEIVED
NOV 10 1949
STATE CORPORATION COMMISSION
KANSAS

(If additional description is necessary, use BACK of this sheet)

Correspondence regarding this well should be addressed to A. L. Rhodes, Phillips Petroleum Company,
Address Box 779, Great Bend, Kansas

STATE OF KANSAS, COUNTY OF BARTON, ss.

A. L. Rhodes (employee of owner) or (owner or operator) of the above-described well,
being first duly sworn on oath, says: That I have knowledge of the facts, statements, and matters herein contained and the log of the above-described well as filed and that the same are true and correct. So help me God.


(Signature) A. L. Rhodes

Box 779, Great Bend, Kansas
(Address)

SUBSCRIBED AND SWORN TO before me this 7th day of November, 1949.

My commission expires March 27, 1950.

[Signature]
Notary Public.

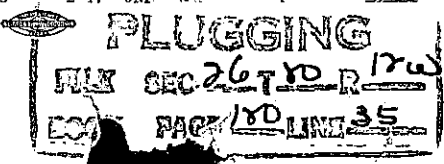

Formation Record

Lease Schrepel

Well No. 1

FROM	TO	Formation	REMARKS
0	224	Surface sand	Elevation 1826' BP
224	352	Shale & Red Bed	
352	708	Red Bed, Shale & Shells	
708	1265	Shale & Shells	
1265	1467	Shale, Shells & Salt	
1467	1607	Shale & Lime	
1607	1709	Lime	
1709	2824	Lime & Shale	
2824	3387	NTD Lime	
3387	3452	Lime	

Formation Tops -

Topoka	2742 (Elec. log)
Heebner	3008
Toronto	3022
Brown Lime	3132
L.K.C.	3150
Arbuckle	3383
Rotary TD	3387

Toronto Zone:
3026-34

Poor crystalline porosity; trace spotted stain.

L.K.C. Zones:
3152-57
3164-70

Poor crystalline porosity; trace spotted to even stain, slight odor.
Poor to fair oolitic to slightly oolitic porosity, trace spotted stain, spotted show free oil, fair odor.

3237-61
3274-84


Poor to fair oolitic to crystalline porosity, no shows.
Fair oolitic porosity, trace dark residual stain, trace heavy dark free oil, very slight odor.

3312-24

Poor to fair oolitic porosity, no shows.

Arbuckle Zone:
3383-TD

Poor to fair porosity, fair saturation, fair odor, slight show free oil.

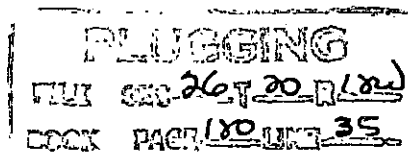

RECEIVED

Conservation Div.

NOV 10 1949

STATE CORPORATION
COMMISSION
KANSAS