


R
WELL PLUGGING RECORD

Give All Information Completely
Make Required Affidavit
Mail or Deliver Report to:
Conservation Division
State Corporation Commission
211 No. Broadway
Wichita, Kansas

Barton County, Sec. 26 Twp. 20 Rge. 12 (E)W (W)W

Location as "NE/CNW/SW" or footage from lines 990' from S & 330' from E
Lease Owner Lee Drilling Co. line
Lease Name Bryant "C" #5 Well No. C-5
Office Address Odessa, Texas
Character of Well (completed as Oil, Gas or Dry Hole) oil
Date well completed 4-12 1950
Application for plugging filed 19
Application for plugging approved 1-18 1960
Plugging commenced 1-8-60 19
Plugging completed 1-14-60 19
Reason for abandonment of well or producing formation Water

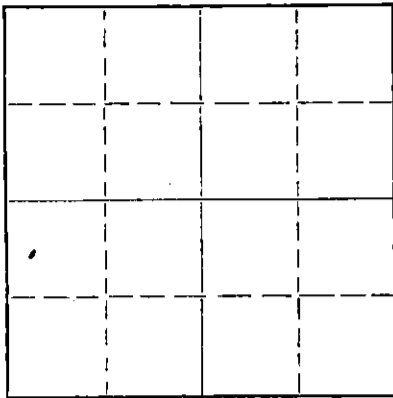

Locate well correctly on above
Section Plat

If a producing well is abandoned, date of last production Sept 19 1959
Was permission obtained from the Conservation Division or its agents before plugging was commenced? yes

Name of Conservation Agent who supervised plugging of this well Don Truan
Producing formation Arkuckle Depth to top 3376 Bottom 3410 Total Depth of Well 3410 Feet
Show depth and thickness of all water, oil and gas formations.

OIL, GAS OR WATER RECORDS				CASING RECORD		
FORMATION	CONTENT	FROM	TO	SIZE	PUT IN	PULLED OUT
				8-5/8"	258'	none
				5-1/2"	3378'	1705'

Describe in detail the manner in which the well was plugged, indicating where the mud fluid was placed and the method or methods used in introducing it into the hole. If cement or other plugs were used, state the character of same and depth placed, from feet to feet for each plug set.

Checked the hole to 3410' and found it open.
Filled w/sand to 3200' and dumped 5 sacks of cement with bailer. Pulled 5 1/2" casing and squeezed well with 15 sacks of gel mud and 75 sacks of cement. Cement filled to 30', ran 10 sacks of cement to base of cellar.

Plugging completed

2-1-1960
RECEIVED
STATE CORPORATION COMMISSION
FEB 1 1960
CONSERVATION DIVISION
Wichita, Kansas

(If additional description is necessary, use BACK of this sheet)
Name of Plugging Contractor Knight Casing Pulling Co.
Address Chase, Kansas

STATE OF KANSAS, COUNTY OF RICE, ss.
I, Noel J. Knight (employee of owner) or (owner/operator) of the above-described well, being first duly sworn on oath, says: That I have knowledge of the facts, statements, and matters herein contained and the log of the above-described well as filed and that the same are true and correct. So help me God.

(Signature) Noel Knight
Chase, Kansas (Address)

SUBSCRIBED AND SWORN TO before me this 25th day of January, 1960

My commission expires 9-27-62 Notary Public.



WELL LOG

Lee Drilling Company
Bryant "C" #5

Sec. 26 T.20S R.12W
990' from South Line &
330' from East Line -

Total Depth - 3410'
Contractor - Quaker Drlg. Co.

County - Barton

CASING

8-5/8" @ 258' cement circulated Elevation - 1825'
5-1/2" @ 3378' cemented with 100 sks

Sand and Surface Shale	0 - 100
Red Rock and Blue Shale	100 - 260
Shale and Shells	260 - 492
Aneyhrite and Syp	492 - 550
Red Rock and Shale	550 - 690
Shale and Gyp	690 - 1276
Salt and Shale	1276 - 1300
Shale and Lime	1300 - 1650
Sand and Shaley Lime	1650 - 1970
Broken Lime	1970 - 2120
Shale and Lime	2120 - 2241
Hard Lime	2241 - 2393
Shale and Lime Shells	2393 - 2696
Borken Lime	2696 - 3004
Shale	3004 - 3014
Lime, Shaley	3014 - 3127
Brown Lime	3127 - 3138
White Lime	3138 - 3365
Green Shale	3365 - 3376
Arbuckle Lime (Total Depth)	3376 - 3410

RECEIVED
JAN 3 1950
CORPORATION COMMISSION
CONSERVATION DIVISION
Wichita, Kansas

The following tops were picked from samples

Heebner Shale	3004 -1177
Borwn Lime	3127 -1300
White Lansing	3138 -1311
Arbuckle	3376 -1550