


Give All Information Completely
Make Required Affidavit
Mail or Deliver Report to:
Conservation Division
State Corporation Commission
800 Bitting Building
Wichita, Kansas

WELL PLUGGING RECORD

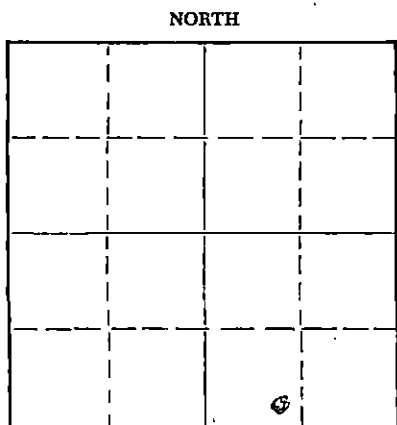

Locate well correctly on above Section Plat

Barton County. Sec. 16 Twp. 20 Rge. (E) 12 (W)
Location as "NE/CNWKSWK" or footage from lines 990' from North - 330' from West
Lease Owner Lee Drilling Company SW/4
Lease Name Bryant "C" Well No. 4
Office Address Philtower Building Tulsa, Oklahoma
Character of Well (completed as Oil, Gas or Dry Hole) Oil
Date well completed 8-7-1949
Application for plugging filed 19
Application for plugging approved 19
Plugging commenced 7-21-1956
Plugging completed 7-25-1956
Reason for abandonment of well or producing formation Water - 400 BBLs, Oil 3 BBLs
If a producing well is abandoned, date of last production 7-3-56 19
Was permission obtained from the Conservation Division or its agents before plugging was commenced? Yes

Name of Conservation Agent who supervised plugging of this well R. M. Brundage
Producing formation Arbuckle Depth to top 3384 Bottom 3420 Total Depth of Well 3420 Feet
Show depth and thickness of all water, oil and gas formations.

OIL, GAS OR WATER RECORDS

CASING RECORD

FORMATION	CONTENT	FROM	TO	SIZE	PUT IN	PULLED OUT
		0	260	8 5/8	260	NONE
		0	3386	5 1/2	3386	2718

Describe in detail the manner in which the well was plugged, indicating where the mud fluid was placed and the method or methods used in introducing it into the hole. If cement or other plugs were used, state the character of same and depth placed, from _____ feet to _____ feet for each plug set.

Sanded hole from 3420 to 3375 - dumped 5 sks cement - mudded to 220' - set 10' rock bridge - dumped 2 sks Calseal - set 2 hrs - bailed dry - dumped 20 sks cement - mudded to 35' - set rock bridge - dumped 10 sks cement to base of cellar.

(If additional description is necessary, use BACK of this sheet)

Name of Plugging Contractor R & D Casing Pulling Company License # 236
Address Box 569 Ellinwood, Kansas

STATE OF Texas, COUNTY OF Midland, ss. Fred Justice

(employee of owner) or (owner or operator) of the above-described well, being first duly sworn on oath, says: That I have knowledge of the facts, statements, and matters herein contained and the log of the above-described well as filed and that the same are true and correct. So help me God.

(Signature) Fred Justice
Box 1373, Odessa, Texas
(Address)

SUBSCRIBED AND SWORN TO before me this 6th day of August, 19 56

V. Pickett V. Pickett
Notary Public.

My commission expires June 1, 1957

RECEIVED RECORDS
STATE CORPORATION COMMISSION

PLUGGING
FILE SEC. 26 T. 20 R. 12W
BOOK PAGE 81 LINE 6

AUG 31 1956
CONSERVATION DIVISION
Wichita, Kansas
8-8-1956

Lee Drilling Company
Bryant "C" # 4

Sec. 26 T. 20S R. 12W
990' from the North line and
330' from the West line of the
SW/4

Total Depth - 3420
Comm. 8-29-49 Comp. 9-7-49
Contractor. Quaker Drilling Company

County - Barton

CASING

8 5/8" @ 260' cement Circulated
5 1/2" @ 3386' Cemented with loo sks

Elevation. 1833

Clay and sand	0 - 90
Sand and shale	90 - 200
Red rock	200 - 260
Shale and shells	260 - 606
Aneyhridte	606 - 628
Shale and Gyp	628 - 1220
Salt and Shale	1220 - 1280
Shale and Lime	1280 - 1610
Sand and Shale Limel	1610 - 1940
Broken Lime	1940 - 2100
Shale & Lime Shells	2100 - 2400
Hard Lime	2400 - 2440
Shale & Lime shels	2440 - 2750
Broken Lime	2750 - 3009
Heebneer Shale	3009 - 3013
Lime	3013 - 3147
Lime White	3147 - 3324
Green Shale	3324 - 3384
Arbuckle Lime	3384 - 3420 T.D.

The following tops were picked from samples

Heebneer	3009 - 1176
Brown Lime	3135 - 1302
White Lansing	3147 - 1314
Arbuckle	3384 - 1551

RECORDED
INDEXED
JUL 1 1955
CONSERVATION DIVISION
WELLS, WARD

PLUGGING
FILE SEC 26 T. 20 R. 12W
BOOK PAGE 81 LINE 6