


STATE OF KANSAS  
STATE CORPORATION COMMISSION

Give All Information Completely  
Make Required Affidavit  
Mail or Deliver Report to:  
Conservation Division  
State Corporation Commission  
P. O. Box 17027  
Wichita, Kansas 67217  
NORTH

WELL PLUGGING RECORD

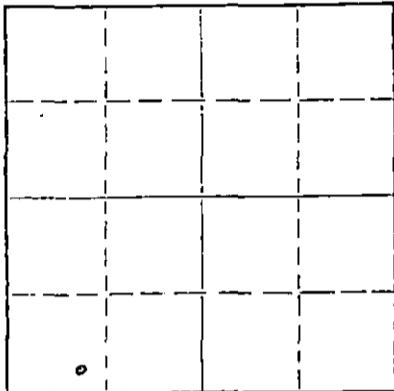

Locate well correctly on above  
Section Plat

Barton County. Sec. 22 Twp. 20 Rge. 11 (E) 11 (W)  
Location as "NE/CNW/SW" or footage from lines. SE SW SW  
Lease Owner F. G. Holl  
Lease Name Kasselmann Well No. 3  
Office Address 6427 E. Kellogg, Wichita, Kansas 67207  
Character of Well (completed as Oil, Gas or Dry Hole) oil  
Date well completed \_\_\_\_\_ 19\_\_\_\_  
Application for plugging filed May 21 1973  
Application for plugging approved \_\_\_\_\_ 19\_\_\_\_  
Plugging commenced July 5 1973  
Plugging completed July 16 1973  
Reason for abandonment of well or producing formation depleted

If a producing well is abandoned, date of last production \_\_\_\_\_ 19\_\_\_\_  
Was permission obtained from the Conservation Division or its agents before plugging was commenced? yes

Name of Conservation Agent who supervised plugging of this well Donald Truan  
Producing formation \_\_\_\_\_ Depth to top \_\_\_\_\_ Bottom \_\_\_\_\_ Total Depth of Well 3386 Feet  
Show depth and thickness of all water, oil and gas formations.

OIL, GAS OR WATER RECORDS

CASING RECORD

FORMATION	CONTENT	FROM	TO	SIZE	PUT IN	PULLED OUT
		0	252'	8 5/8"	252'	none
			3165'	5 1/2"	3165'	2017.62

Describe in detail the manner in which the well was plugged, indicating where the mud fluid was placed and the method or methods used in introducing it into the hole. If cement or other plugs were used, state the character of same and depth placed, from \_\_\_\_\_ feet to \_\_\_\_\_ feet for each plug set.

Sanded back to 3050' and dumped 5 sacks of cement.

Sun Cementing plugged well with 3 sacks of hulls, 20 sacks of mud and 100 sacks of cement.

RECEIVED  
STATE CORPORATION COMMISSION  
JUL 24 1973  
CONSERVATION DIVISION  
Wichita, Kansas

(If additional description is necessary, use BACK of this sheet)  
Name of Plugging Contractor PIPE PULLERS, INC.  
Address Box 486, Ellinwood, Kansas 67526

STATE OF KANSAS, COUNTY OF BARTON, ss.  
Evelyn Roth (employee of owner) or (owner or operator) of the above-described well, being first duly sworn on oath, says: That I have knowledge of the facts, statements, and matters herein contained and the log of the above-described well as filed and that the same are true and correct. So help me God.

(Signature) Evelyn Roth  
Ellinwood, Kansas  
(Address)

SUBSCRIBED AND SWORN TO before me this 23 day of July, 19 73

My commission expires Feb. 10, 1975

George A. Meyer  
Notary Public.

RECEIVED  
STATE CORPORATION COMMISSION

MAY 23 1973

CONSERVATION DIVISION  
Wichita, Kansas

WELL LOG

F. G. Holl, Owner - Kasselmann #3  
SE/4 SW/4 SW/4 Section 22, Township 20, Range 11W,  
Barton County, Kansas

ELEVATION: 1768 DF

Figures indicate bottom of formation  
0 to 135

135 Sand  
220 Shale  
253 Shale & shells  
508 Red Rock  
540 Anhydrite  
1030 Shale & shells  
1240 Salt  
1350 Shale & shells  
1825 Lime & Shale  
2785 Shale & shells  
3080 Lime & shale  
3098 Lime  
3336 Lime & shale  
3386 Conglomerate  
3386 Rotary  
Total Depth

PIPE RECORD:

8-5/8" set at 252'  
Cemented with 275 sacks cement  
400# Calcium Chloride

5-1/2" set at 3165'  
Cemented with 75 sacks cement

Rotary Commenced 1-25-56  
Completed 2- 6-56

Plug back with 100 sacks cement  
displaced through Drill Pipe  
to 3190'.

STATE OF KANSAS )  
COUNTY OF BARTON ) SS

I, M. M. Shropshire, Drilling Superintendent of the above-described well, being first duly sworn on oath, declare: That I have knowledge of the facts, statements and matters herein contained pertaining to the log of the above-described well, as filed, and that the same are true and correct.

M. M. Shropshire

Subscribed and Sworn to before me this 7th day of February, 1956.

George A Meyer  
Notary Public

My commission expires Feb. 10, 1959.