

STATE OF KANSAS
STATE CORPORATION COMMISSION


WELL PLUGGING RECORD

OR
FORMATION PLUGGING RECORD

Strike out upper line when reporting plugging off formations.

Give All Information Completely
Make Required Affidavit
Mail or Deliver Report to:
Conservation Division
State Corporation Commission
800 Biting Building
Wichita, Kansas

NORTH

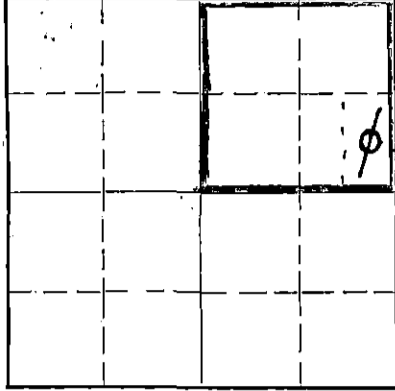

Locate well correctly on above Section Plat

Barton County. Sec. 22 Twp. 20S Rge. (E) 11(W)
Location as "NE $\frac{1}{4}$ NW $\frac{1}{4}$ SW $\frac{1}{4}$ " or footage from lines SE $\frac{1}{4}$ of NE $\frac{1}{4}$
Lease Owner Champlin Refining Company
Lease Name Fiage Well No. 1
Office Address Enid, Okla.
Character of Well (Completed as Oil, Gas or Dry Hole) Dry
Date, well completed 5-30-40 193
Application for plugging filed 5-31-40 193
Application for plugging approved 5-31-40 193
Plugging Commenced 5-31-40 193
Plugging Completed 5-31-40 193
Reason for abandonment of well or producing formation Dry hole

If a producing well is abandoned, date of last production 193
Was permission obtained from the Conservation Division or its agents before plugging was commenced?
Yes

Name of Conservation Agent who supervised plugging of this well C. T. Alexander
Producing formation Depth to top Bottom Total Depth of Well 3415 Feet.
Show depth and thickness of all water, oil and gas formations.

OIL, GAS OR WATER RECORDS


CASING RECORD

Formation	Content	From	To	Size	Put In	Pulled Out
				10 3/4"	222'	None

Describe in detail the manner in which the well was plugged, indicating where the mud fluid was placed and the method or methods used in introducing it into the hole. If cement or other plugs were used, state the character of same and depth placed, from feet to feet for each plug set.

Mud from 3415 to 222 feet and bridged; put in 20 sacks of cement with Halliburton process; filled in mud to 10 ft. of surface and cemented to 4 ft. of top of surface.

6-15-40

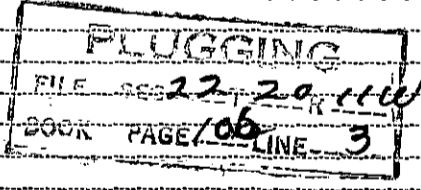

(If additional description is necessary, use BACK of this sheet)

Correspondence regarding this well should be addressed to Champlin Refining Co.,
Address Enid, Okla.

STATE OF Oklahoma COUNTY OF Garfield, ss.
Gail Nusbaum (employee of owner) of the above-described well,
being first duly sworn on oath, says: That I have knowledge of the facts, statements, and matters herein contained and the log of the above-described well as filed and that the same are true and correct. So help me God.

(Signature) Gail Nusbaum

Enid, Okla.
(Address)

SUBSCRIBED AND SWORN TO before me this 14 day of June, 1940.

My commission expires Dec. 7, 1941

R. E. Miller

Notary Public.

FORMATION RECORD

Give detailed description and thickness of all formations drilled through and contents of sand, whether dry, water, oil or gas

Formation	Top	Bottom	Formation	Top	Bottom
Surface hole, red beds	0	- 208			
red beds	208	485			
anhydrite	485	505			
shale & shells	505	1230			
shale, lime & gyp shells	1230	1400			
lime & shale	1400	1530			
shale & lime	1530	1650			
lime & shale	1650	2065			
shale & lime shells	2065	2195			
shale	2195	2345			
lime & shale	2345	2525			
shale & lime	2525	2610			
shale	2610	2640			
brkn lime & shale	2640	2660			
lime	2660	2750			
lime & shale	2750	2870			
lime	2870	2910			
broken lime	2910	2940			
shale & shells	2940	3045			
shale	3045	3090			
lime	3090	3245			
lime & shale	3245	3293			
lime	3293	3299			
shale & lime brkn	3299	3330			
lime & chert	3330	3373			
lime	3373	3387			
shale	3387	3399			
lime	3399	3415	T.D.		