


STATE OF KANSAS
STATE CORPORATION COMMISSION

Give All Information Completely
Make Required Affidavit
Mail or Deliver Report to:
Conservation Division
State Corporation Commission
P. O. Box 17027
Wichita, Kansas 67217
NORTH

WELL PLUGGING RECORD

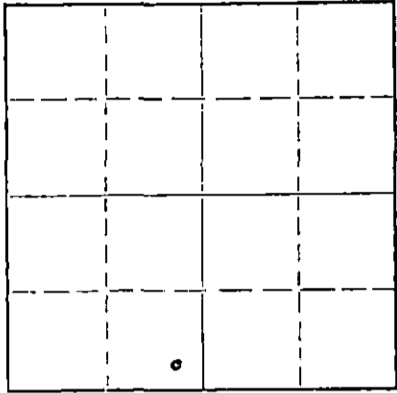

Locate well correctly on above
Section Plat

Barton County, Sec. 22 Twp. 20 Rge. (E) 11 (W)
Location as "NE/CNW/SW" or footage from lines SE SE SW
Lease Owner F. G. Holl
Lease Name Kasselman Well No. 2
Office Address 6427 E. Kellogg, Wichita, Kansas 67207
Character of Well (completed as Oil, Gas or Dry Hole) oil
Date well completed _____ 19____
Application for plugging filed May 23 19 73
Application for plugging approved _____ 19____
Plugging commenced May 31 19 73
Plugging completed June 5 19 73
Reason for abandonment of well or producing formation depleted

If a producing well is abandoned, date of last production _____ 19____
Was permission obtained from the Conservation Division or its agents before plugging was commenced? yes

Name of Conservation Agent who supervised plugging of this well Donald Truan
Producing formation _____ Depth to top _____ Bottom _____ Total Depth of Well 3158 Feet
Show depth and thickness of all water, oil and gas formations.

OIL, GAS OR WATER RECORDS CASING RECORD

FORMATION	CONTENT	FROM	TO	SIZE	PUT IN	PULLED OUT
		0	248'	10 3/4"	248'	none
			3154'	7"	3154'	1499.84

Describe in detail the manner in which the well was plugged, indicating where the mud fluid was placed and the method or methods used in introducing it into the hole. If cement or other plugs were used, state the character of same and depth placed, from _____ feet to _____ feet for each plug set.

Sanded back to 3130' and dumped 6 sacks of cement.
Plugged well with 25 sacks of gel and 125 sacks of cement.

6-12-73
RECEIVED
STATE CORPORATION COMMISSION
JUN 12 1973
CONSERVATION DIVISION
Wichita, Kansas

(If additional description is necessary, use BACK of this sheet)
Name of Plugging Contractor PIPE PULLERS, INC.
Address Box 486, Ellinwood, Kansas 67526

STATE OF KANSAS, COUNTY OF BARTON, ss.
Evelyn Roth

(employee of owner) or (owner or operator) of the above-described well, being first duly sworn on oath, says: That I have knowledge of the facts, statements, and matters herein contained and the log of the above-described well as filed and that the same are true and correct. So help me God.

(Signature) Evelyn Roth
Ellinwood, Kansas
(Address)

SUBSCRIBED AND SWORN to before me this 11th day of June, 19 73

My commission expires Feb. 10, 1975
George A Meyer
Notary Public.

15.009.00913.0000

KANSAS GEOLOGICAL SOCIETY
KANSAS WELL LOG BUREAU - KANSAS WELL SAMPLE BUREAU
KANSAS GEOLOGICAL SOCIETY BUILDING
508 EAST MURDOCK - WICHITA, KANSAS

COPY

COMPANY F. G. HOLL

SEC. 22 T. 20 R. 11W
LOC. SE SE SW

FARM Kasselmann

NO. 2

TOTAL DEPTH 3158'

COUNTY Barton


COMM. 7-22-50

COMP. 8-16-50

SHOT OR TREATED

CONTRACTOR Herndon Drlg. Co.

ISSUED

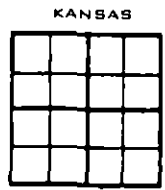

CASING

20	10 3/4"	248'	cem w/200 sx.
15	8 7"	3154'	cein w/150 sx.
12	6		
13	5		

ELEVATION

PRODUCTION 838 BO &
24% Wtr.

FIGURES INDICATE BOTTOM OF FORMATIONS

sand & shale	248
shale & shells	500
Anhydrite	530
shale & shells	1345
shale & lime	1720
lime	2250
shale & shells	2420
shale & lime	2440
lime	2930
lime & shale	3054
lime	3155
lime	3158
Total Depth	

TOPS: SCOUT

Sand	2930
Heebner	2927
Brown Lime	3049
Lime	3068

RECEIVED
STATE CORPORATION COMMISSION

MAY 24 1973

CONSERVATION DIVISION
Wichita, Kansas