


WELL PLUGGING RECORD

Give All Information Completely
Make Required Affidavit
Mail or Deliver Report to:
Conservation Division
State Corporation Commission
800 Building
Wichita, Kansas

Barton County. Sec. 28 Twp. 20 Rge. (E) 12 (W)
Location as "NE/CNW/SW" or footage from lines SE SE SE 1/4
Lease Owner M. B. Armer
Lease Name Ida Brown Well No. 4
Office Address 710 Petroleum Bldg. Wichita, Kansas
Character of Well (completed as Oil, Gas or Dry Hole) Dry
Date well completed August 3, 19 55
Application for plugging filed August 3, 19 55
Application for plugging approved August 3, 19 55
Plugging commenced August 3, 19 55
Plugging completed August 3, 19 55
Reason for abandonment of well or producing formation Dry

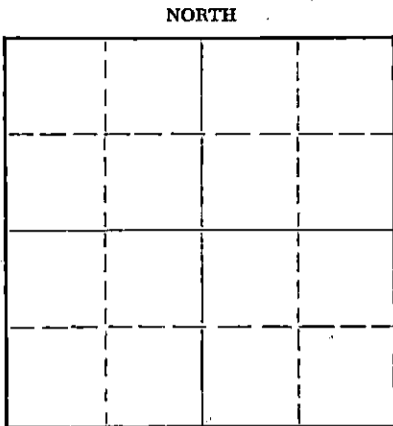

Locate well correctly on above Section Plat

If a producing well is abandoned, date of last production 19
Was permission obtained from the Conservation Division or its agents before plugging was commenced? yes

Name of Conservation Agent who supervised plugging of this well Warren H. Horner
Producing formation _____ Depth to top _____ Bottom _____ Total Depth of Well 3470 Feet
Show depth and thickness of all water, oil and gas formations.

OIL, GAS OR WATER RECORDS

CASING RECORD

FORMATION	CONTENT	FROM	TO	SIZE	PUT IN	PULLED OUT
				8 5/8	261	None

Describe in detail the manner in which the well was plugged, indicating where the mud fluid was placed and the method or methods used in introducing it into the hole. If cement or other plugs were used, state the character of same and depth placed, from _____ feet to _____ feet for each plug set.

Filled hole with heavy Rotary mud to 260 ft. Set plug and 1/3 sack Hulls and 20 sacks cement through drill pipe. Mudded to 35 ft., set plug and 1/3 sack Hulls and 10 sacks cement to surface.

(If additional description is necessary, use BACK of this sheet)

Name of Plugging Contractor Armer, Inc.
Address 710 Petroleum Bldg. Wichita, Kansas

STATE OF Kansas, COUNTY OF Sedgwick, ss.

(employee of owner) or (owner or operator) of the above-described well, being first duly sworn on oath, says: That I have knowledge of the facts, statements, and matters herein contained and the log of the above-described well as filed and that the same are true and correct. So help me God.

(Signature) [Signature]
(Address) _____

SUBSCRIBED AND SWORN TO before me this 10th day of August 1955

My commission expires Feb 13, 1956

Notary Public
STATE CORPORATION COMMISSION
AUG 11 1955
Wichita, Kansas

PLUGGING
WEL SEC 28 TWP 20 R 12W
BOOK PAGE 149 LINE 38

15.009.19515.0000

KANSAS GEOLOGICAL SOCIETY
KANSAS WELL LOG BUREAU - KANSAS WELL SAMPLE BUREAU
KANSAS GEOLOGICAL SOCIETY BUILDING
508 EAST MURDOCK - WICHITA, KANSAS

COMPANY M. B. Armer

SE SE SE

SEC. 28 T. 20 R. 12W

FARM Brown

NO. 4

LOC. SE SE SE
330' N of S Line
295' W of E Line


TOTAL DEPTH 3470
COMM. 7/26/55

COMP. 8/3/55

COUNTY Barton

KANSAS

SHOT OR TREATED
CONTRACTOR Armer, Inc.
ISSUED

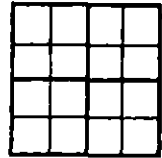

CASING

20	10	
15	8	264'
12	6	
13	5	

ELEVATION 1839 K.B.

PRODUCTION D & A

FIGURES INDICATE BOTTOM OF FORMATIONS

Sand & Red Bed	264
Shale & Shells	625
Anhydrite	647
Red Bed & Shells	1015
Shale & Shells	1515
Shale & Lime	2135
Shale & Shells	2250
Shale & Lime Streaks	2500
Shale & Shells	2685
Shale & Lime	2795
Broken Lime	2875
Shale & Lime	3375
Shale Chert	3470 T.D.

FORMATION TOPS

HEEBNER	3032
BROWN LIME	3157
LANSING-K.C.	3174
CHERTY CONGL.	3404
T.D.	3470

I hereby certify that this is a true and correct log of the above described well as shown by the drilling reports.

ARMER, INC.

By *L.P. Spaulding*

STATE OF KANSAS)
) SS:
COUNTY OF SEDGWICK)

Subscribed and sworn to before me, a notary public, in and for said County and State this 9th day of August, 1955.

Rose Jurey
Notary Public

My commission expires February 13, 1956.

RECEIVED
REGISTRATION COMMISSION
AUG 11 1955
CONSERVATION DIVISION
Wichita, Kansas

PLUGGING
FLX SEC 28 T. 20 R. 12W
BOOK PAGE 40 LINE 38