


WELL PLUGGING RECORD

Give All Information Completely
Make Required Affidavit
Mail or Deliver Report to:
Conservation Division
State Corporation Commission
211 No. Broadway
Wichita, Kansas

NORTH

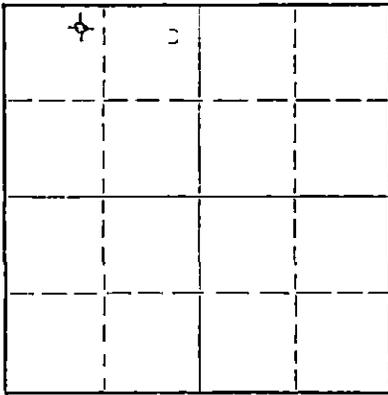

Locate well correctly on above
Section Plat

Barton County. Sec 28 Twp. 20 Rge. 12 (E) W (W)
Location as "NE/CNW/SW" or footage from lines NE NW NW
Lease Owner C-G Drilling Co. & Oil Trading Associates, Inc.
Lease Name Anderson Well No. 3
Office Address 107 Rule Building, Wichita, Kansas
Character of Well (completed as Oil, Gas or Dry Hole) Dry Hole
Date well completed January 29 1957
Application for plugging filed January 29 1957
Application for plugging approved January 29 1957
Plugging commenced January 30 1957
Plugging completed January 30 1957
Reason for abandonment of well or producing formation Too low structurally

If a producing well is abandoned, date of last production _____ 19____
Was permission obtained from the Conservation Division or its agents before plugging was commenced? Yes

Name of Conservation Agent who supervised plugging of this well Eldon Petty, Hays, Kansas
Producing formation _____ Depth to top _____ Bottom _____ Total Depth of Well 3470 Feet
Show depth and thickness of all water, oil and gas formations.

OIL, GAS OR WATER RECORDS

CASING RECORD

FORMATION	CONTENT	FROM	TO	SIZE	PUT IN	PULLED OUT
				8-5/8"	255'	none

Describe in detail the manner in which the well was plugged, indicating where the mud fluid was placed and the method or methods used in introducing it into the hole. If cement or other plugs were used, state the character of same and depth placed, from _____ feet to _____ feet for each plug set.

Filled hole with heavy mud to
250'. Set plug. Put in 1/2
sack Hulls and 15 sacks cement.
Filled with heavy mud up to 40'
Set plug. Filled to top with
1/2 sack Hulls and 10 sacks
cement.

RECEIVED
STATE CORPORATION COMMISSION

2-2-57 FEB 2 1957

CONSERVATION DIVISION
Wichita, Kansas

(If additional description is necessary, use BACK of this sheet)

Name of Plugging Contractor C-G Drilling Co.
Address 107 Rule Building, Wichita, Kansas

STATE OF KANSAS, COUNTY OF SEDGWICK, ss.
G. F. Galloway (employee of owner) or (owner or operator) of the above-described well, being first duly sworn on oath, says: That I have knowledge of the facts, statements, and matters herein contained and the log of the above-described well as filed and that the same are true and correct. So help me God.

(Signature) G. F. Galloway
107 Rule Building
(Address)

SUBSCRIBED AND SWORN TO before me this 31st day of January, 1957

My commission expires May 20, 1959 Vicky Jacobs Notary Public.

PLUGGING
FILE SEC. _____ T. _____ R. _____
BOOK PAGE _____ LINE _____

CONTRACTOR'S WELL LOG

OPERATOR C-G Drilling Co. & Oil Trading Associates, Inc. WELL NAME Anderson #3
 LOCATION NE NW NW Sec. 28-20S-12W RIG NO. 2
 COUNTY Barton STATE Kansas
 COMMENCEMENT DATE January 21, 1957 Completion DATE January 29, 1957

LOG OF WELL

Elevation 1847' Kelly bushing.
 All measurements taken from the top of Kelly bushing.

FROM	TO	FORMATION	DEVIATION FROM VERTICAL	REMARKS:
0	160	Sand		
160	246	Blue Shale		
246	266	Shale		
266	626	Red Rock		
626	646	Anhydrite		
646	1470	Shale-Shells		
1470	1510	Shale-Lime		
1510	1625	Shale-Lime		
1625	1805	Lime		
1805	1930	Lime-Shale		
1930	2195	Lime-Shale		
2195	2350	Lime-Shale		
2350	2500	Lime-Shale	0° - 2500	
2500	2760	Lime-Shale	0° - 2750	
2760	2870	Shale-Lime		
2870	2985	Lime-Shale		
2985	3091	Lime	0° - 3000	
3091	3208	Lime-Shale		
3208	3367	Lime	0° - 3250	
3367	3470	Lime		

CASING LEFT IN HOLE AFTER COMPLETION

Ran 255' (13 jts.) 8-5/8" OD Surface casing.

STATE OF KANSAS }
 COUNTY OF SEDGWICK } ss.

RECEIVED
 STATE CORPORATION COMMISSION
 FEB - 2 1957
 CONSERVATION DIVISION
 Wichita, Kansas

The undersigned hereby certifies that to the best of his knowledge and belief, the above facts are true and correct.

C-G DRILLING CO.

By G. F. Galloway
 G. F. Galloway

Subscribed and sworn to before me this 31st day of January, 1957.

My commission expires:
 May 20, 1959

Vicky Jacobs
 Vicky Jacobs, Notary Public

PLUGGING
 FILE SEC. 28 T. 20 R. 12W
 BOOK PAGE 137 LINE 42