


Give All Information Completely  
Make Required Affidavit  
Mail or Deliver Report to:  
Conservation Division  
State Corporation Commission  
112 North Market, Insurance Bldg.  
Wichita, Kansas

WELL PLUGGING RECORD

NORTH

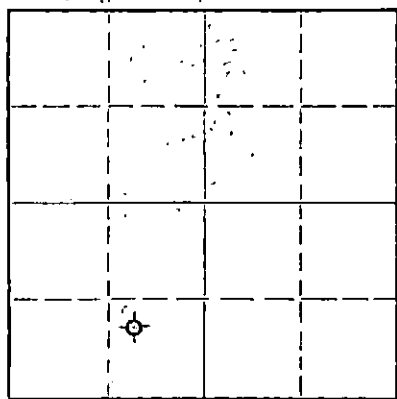

Locate well correctly on above  
Section Plat

Barton County. Sec. 28 Twp. 20 Rge. 12 (E) W (W)  
Location as "NE/CNW/SW" or footage from lines NW SE SW  
Lease Owner L. K. Parrish  
Lease Name Lydia Well No. 5  
Office Address Fourth National Bank Bldg., Wichita 2, Kansas  
Character of Well (completed as Oil, Gas or Dry Hole) Dry Hole  
Date well completed July 8 1961  
Application for plugging filed July 8 1961  
Application for plugging approved July 8 1961  
Plugging commenced July 8 1961  
Plugging completed July 8 1961  
Reason for abandonment of well or producing formation Too low structurally

If a producing well is abandoned, date of last production \_\_\_\_\_ 19\_\_\_\_  
Was permission obtained from the Conservation Division or its agents before plugging was commenced? Yes

Name of Conservation Agent who supervised plugging of this well Eldon Petty, Hays, Kansas  
Producing formation \_\_\_\_\_ Depth to top \_\_\_\_\_ Bottom \_\_\_\_\_ Total Depth of Well 3525 Feet  
Show depth and thickness of all water, oil and gas formations.

OIL, GAS OR WATER RECORDS

CASING RECORD

FORMATION	CONTENT	FROM	TO	SIZE	PUT IN	PULLED OUT
				8-5/8"	281.85'	None

Describe in detail the manner in which the well was plugged, indicating where the mud fluid was placed and the method or methods used in introducing it into the hole. If cement or other plugs were used, state the character of same and depth placed, from \_\_\_\_\_ feet to \_\_\_\_\_ feet for each plug set.

Filled hole with heavy mud to 240'. Set plug. Put in 20 sacks cement. Put in 1/2 sack hulls. Filled to 35'. Set plug. Put in 1/4 sack hulls and 8 sacks cement.

RECEIVED  
STATE CORPORATION COMMISSION  
JUL 17 1961  
CONSERVATION DIVISION  
Wichita, Kansas

(If additional description is necessary, use BACK of this sheet)

Name of Plugging Contractor C-G Drilling Co.  
Address 107 Rule Building, Wichita 2, Kansas

STATE OF KANSAS, COUNTY OF SEDGWICK, ss.  
G. F. Galloway (employee of owner) or (owner or operator) of the above-described well, being first duly sworn on oath, says: That I have knowledge of the facts, statements, and matters herein contained and the log of the above-described well as filed and that the same are true and correct. So help me God.

(Signature) G. F. Galloway  
107 Rule Building  
(Address)

SUBSCRIBED AND SWORN to before me this 13th day of JULY, 1961

My commission expires May 20, 1963

Vicky Jacobs  
Notary Public.



W E L L L O G

OPERATOR L. K. Parrish SEC. 28-20-12W  
 WELL NAME Lydia #5 LOC. NW SE SW  
 TOTAL DEPTH 3525' COUNTY Barton  
 COMPI. June 28, 1961 COMP. July 8, 1961 STATE Kansas  
 FIG NO. 2 ELEVATION 1854' K.B.

CASING: Ran 281.85' (10 jts.) 8-5/8" OD Surface Casing. PRODUCTION: D & A

All measurements taken from the top of rotary bushing.

FROM	TO	FORMATION	DEVIATION FROM VERTICAL	REMARKS:
0	230	Sand		
230	635	Red Bed		
635	665	Anhydrite		
665	1450	Shale & Shells		
1450	1705	Shale & Lime		
1705	2110	Lime & Shale	0° - 2500	
2110	3054	Shale & Lime	0° - 2750	
3054	3445	Lime	0° - 3000	DST 3442-3452'
3445	3525'	Arbuckle	0° - 3250	DST 3455-3478'
			0° - 3500	DST 3508-3525'

RECEIVED  
 STATE CORPORATION COMMISSION  
 JUL 17 1961  
 CONSERVATION DIVISION  
 Wichita, Kansas

STATE OF KANSAS }  
 COUNTY OF SEDGWICK } SS.

The undersigned hereby certifies that to the best of his knowledge and belief, the above facts are true and correct.

C-G DRILLING CO.

By G. F. Galloway  
 G. F. Galloway

THIS 13th day of July, 1961.

Vicky Jacobs  
 Vicky Jacobs - Notary public

