

STATE OF KANSAS  
STATE CORPORATION COMMISSION

WELL PLUGGING RECORD

Give All Information Completely  
Make Required Affidavit  
Mail or Deliver Report to:  
Conservation Division  
State Corporation Commission  
212 No. Market  
Wichita, Kansas

Barton County. Sec. 28 Twp. 20 Rge. (E) 12 (W)

Location as "NE/CNW/SW" or footage from lines NW NE SW

Lease Owner L. K. Parrish

Lease Name Lyda Well No. 4

Office Address 714 Fourth National Bldg., Wichita, Kansas

Character of Well (completed as Oil, Gas or Dry Hole) oil

Date well completed \_\_\_\_\_ 19\_\_

Application for plugging filed April 6 1966

Application for plugging approved \_\_\_\_\_ 19\_\_


Plugging commenced April 8 1966

Plugging completed April 11 1966

Reason for abandonment of well or producing formation depleted

If a producing well is abandoned, date of last production \_\_\_\_\_ 19\_\_

Was permission obtained from the Conservation Division or its agents before plugging was commenced? yes

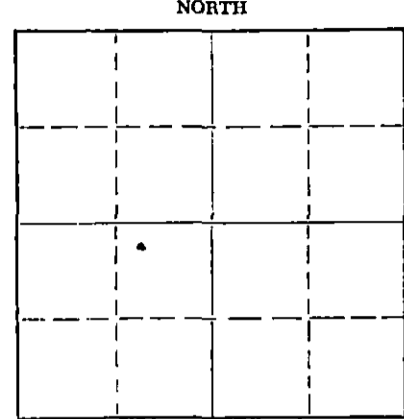

Locate well correctly on above Section Plat

Name of Conservation Agent who supervised plugging of this well Donald Truan

Producing formation \_\_\_\_\_ Depth to top \_\_\_\_\_ Bottom \_\_\_\_\_ Total Depth of Well 3453' Feet

Show depth and thickness of all water, oil and gas formations.

OIL, GAS OR WATER RECORDS

CASING RECORD

FORMATION	CONTENT	FROM	TO	SIZE	PUT IN	PULLED OUT
		0	270'	8 5/8"	270'	none
		0	3440'	5 1/2"	3440'	2661.85

Describe in detail the manner in which the well was plugged, indicating where the mud fluid was placed and the method or methods used in introducing it into the hole. If cement or other plugs were used, state the character of same and depth placed, from \_\_\_\_\_ feet to \_\_\_\_\_ feet for each plug set.

Pushed plug to 3430', set 10' rock bridge and dumped 5 sacks of cement at 3420'.  
Pushed plug to 255', set 10' rock bridge and dumped 3 sacks of cement at 245'. Mixed 3 sacks of cement with 4 gallons of calcium chloride and dumped at 245'. Dumped 25 gallons of sand on top of cement.  
Bailed hole down and dumped 19 sacks of cement. Filled hole with mud to 40', set 10' rock bridge and capped hole with 10 sacks of cement.

RECEIVED  
STATE CORPORATION COMMISSION

4-13-66 APR 13 1966

CONSERVATION DIVISION  
Wichita, Kansas

Name of Plugging Contractor Pipe Pullers, Inc.  
Address Box 486, Ellinwood, Kansas

STATE OF Kansas, COUNTY OF Barton, ss. Dean Wells (employee of owner) or (~~owner or operator~~) of the above-described well, being first duly sworn on oath, says: That I have knowledge of the facts, statements, and matters herein contained and the log of the above-described well as filed and that the same are true and correct. So help me God.

(Signature) Dean Wells

Ellinwood, Kansas  
(Address)

SUBSCRIBED AND SWORN TO before me this 12th day of April, 1966

My commission expires July 7, 1968

J. Hader  
Notary Public.

WELL LOG

L. K. PARRISH

Commenced: June 14, 1959

Contractor: Quaker Drilling Co., Inc..

Completed: June 22, 1959

Lyda No. 4  
NW NE SW Section 28-20S-12W  
Barton County, Kansas

Elevation: 1848 KB

## Casing Record:

Set 8 5/8 inch casing at 270 feet with 240 sacks cement.  
Set 5 1/2 inch casing at 3440 feet with 75 sacks cement.

(Figures Indicate the Bottom of the Formations)

<u>FORMATION</u>	<u>DEPTH</u>	<u>FORMATION TOPS</u>
Sand	207	Heebner 3045 -1197
Shale	270	Brown Lime 3169 -1321
Red Bed, Shale and Sand	600	Lansing 3187 -1339
Red Bed	628	Base of Kansas City 3402 -1554
Anhydrite	656	Conglomerate 3417 -1569
Shale and Shells	1470	Arbuckle 3438 -1590
Lime and Shale	1687	Rotary Total Depth 3448 -1600
Shale and Sandy Lime	1885	
Lime and Shale	1955	
Shale and Shells	2700	
Shale and Lime	2885	
Lime	2950	
Lime and Shale	3345	
Lime	3405	
Lime and Shale	3438	
Dolomite	3448	

RECEIVED  
STATE CORPORATION COMMISSION

APR 15 1966

CONSERVATION DIVISION  
Wichita, Kansas

We hereby certify the foregoing to be a true and correct copy of the Driller's Log of the Well drilled in the NW NE SW of Section 28, Township 20 South, Range 12 West, Barton County, Kansas.

QUAKER DRILLING CO., INC.

By: Thomas M. McCaul  
Thomas M. McCaul, President

SUBSCRIBED AND SWORN TO before me a Notary Public this 25th day of June, 1959.

Virginia Mandell  
Virginia Mandell, Notary PublicMY COMMISSION EXPIRES:  
August 10, 1961