

STATE OF KANSAS
STATE CORPORATION COMMISSION

WELL PLUGGING RECORD


FORMATION PLUGGING RECORD

Give All Information Completely
Make Required Affidavit
Mail or Deliver Report to:
Conservation Division
State Corporation Commission
800 Bitting Building
Wichita, Kansas

OR

Strike out upper line
when reporting plug-
ging off formations.

Barton County. Sec. 28 Twp. 20 Rge. 12 (E) (W)
Location as "NE $\frac{1}{4}$ NW $\frac{1}{4}$ SW $\frac{1}{4}$ " or footage from lines NE. NE. NE
Lease Owner Gough Davis & Quaker Drilling Co., Inc.
Lease Name E. Spacil Well No. 1
Office Address 300 Bitting Bldg., Wichita, Kansas
Character of Well (completed as Oil, Gas or Dry Hole) Dry Hole
Date well completed 9-30 1949
Application for plugging filed 9-30 1949
Application for plugging approved 9-30 1949
Plugging commenced 9-30 1949
Plugging completed 9-30 1949
Reason for abandonment of well or producing formation.....

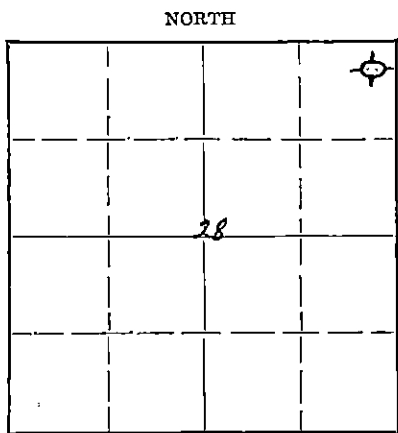

Locate well correctly on above
Section Plat

If a producing well is abandoned, date of last production..... 19.....
Was permission obtained from the Conservation Division or its agents before plugging was com-
menced? Yes.

Name of Conservation Agent who supervised plugging of this well C. D. Stough
Producing formation..... Depth to top..... Bottom..... Total Depth of Well 3490 Feet
Show depth and thickness of all water, oil and gas formations.

OIL, GAS OR WATER RECORDS

CASING RECORD

Formation	Content	From	To	Size	Put In	Pulled Out
				8 5/8"	260'	Cemented.

Describe in detail the manner in which the well was plugged, indicating where the mud fluid was placed and the method or methods used in introducing it into the hole. If cement or other plugs were used, state the character of same and depth placed, from..... feet to..... feet for each plug set.

Heavy mud from 3490 to 260 feet.
Solid plug and 15 sacks through
drill pipe. Heavy mud to 35 feet,
and 10 sacks cement to base cellar.

RECEIVED
OCT 4 X 1949 10-4-49
STATE CORPORATION
COMMISSION
KANSAS

(If additional description is necessary, use BACK of this sheet)
Correspondence regarding this well should be addressed to Quaker Drilling Co., Inc.
Address 300 Bitting Bldg., Wichita, Kansas

STATE OF Kansas, COUNTY OF Sedgwick, ss.
Thomas M. McCaul (employee of owner) or (owner or operator) of the above-described well,
being first duly sworn on oath, says: That I have knowledge of the facts, statements, and matters herein contained and the log of the above-
described well as filed and that the same are true and correct. So help me God.
(Signature) Thomas M. McCaul
President
300 Bitting Bldg., Wichita, Kansas
(Address)

SUBSCRIBED AND SWORN to before me this 3rd day of October, 19 49
Law Ann Allen
Notary Public.

My commission expires August 8, 1953.

PLUGGING
FILE SEC 28T 20 R 12W
BOOK PAGE 17 LINE 27

WELL LOG

Gough Davis - Quaker Drilling Co., Inc.

Contractor: Quaker Drilling Co., Inc.

E. Spacil No. 1

NE NE NE Section 28-20S-12W
Barton County, Kansas

Elevation: 1842 (R.B.)

Commenced: 9-22-49

Completed: 9-30-49

Production: Dry and Abandoned

Casing Record:

Set 8 5/8" at 260' with 225 sacks cement.

(Figures Indicate Bottom of Formations)

<u>FORMATION</u>	<u>DEPTH</u>	<u>FORMATION TOPS</u>		
Surface Clay & Sand	165	Heebner Shale	3028	-1186
Shale	260	Brown Lime	3153	-1311
Shale & Red Bed	610	White Lansing	3171	-1329
Shale & Lime	2885	Conglomerate	3423	-1581
Lime	2965	Arbuckle	3482	-1640
Lime & Shale	3423	Total Depth	3490	-1648
Cherty Lime & Shale	3482			
Dolomite	3490			

RECEIVED

Conservation Div.

OCT 4 X 1949

STATE CORPORATION
COMMISSION
KANSAS

I hereby certify that the above is a true and correct copy of Driller's Log of well drilled in the NE NE NE of Section 28, Township 20 South, Range 12 West, Barton County, Kansas.

QUAKER DRILLING CO., INC.

By: Thomas M. McCall
PresidentSubscribed and sworn to before me this 4th day of October, 1949.Low Ann Allen
Notary Public

My Commission Expires: August 8, 1953.

