


15.009.05809.0000

STATE OF KANSAS
STATE CORPORATION COMMISSION

WELL PLUGGING RECORD

Give All Information Completely
Make Required Affidavit
Mail or Deliver Report to:
Conservation Division
State Corporation Commission
211 No. Broadway
Wichita, Kansas

Barton County. Sec. 16 Twp. 20 Rge. 12 (E) W (W)
Location as "NE/CNW/SW" or footage from lines SW SE NE
Lease Owner PETROLEUM INC.
Lease Name HULME "F" Well No. 1
Office Address Route 2, Great Bend, Kansas
Character of Well (completed as Oil, Gas or Dry Hole) Dry Hole
Date well completed February 9 1957
Application for plugging filed February 9 1957
Application for plugging approved February 9 1957
Plugging commenced February 9 1957
Plugging completed February 10 1957
Reason for abandonment of well or producing formation No Producible Zones

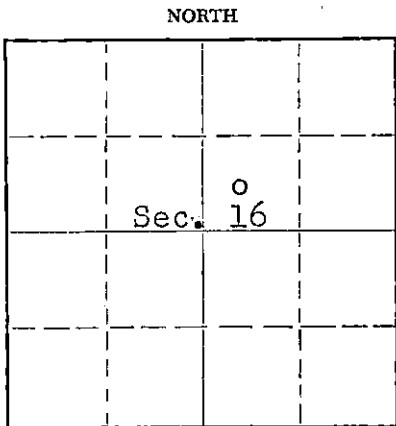

Locate well correctly on above
Section Plat

If a producing well is abandoned, date of last production None 19
Was permission obtained from the Conservation Division or its agents before plugging was commenced? Yes

Name of Conservation Agent who supervised plugging of this well R.M Brundage, Box 283, Hoisington, Kansas

Producing formation ----- Depth to top --- Bottom --- Total Depth of Well 3448 Feet
Show depth and thickness of all water, oil and gas formations.

OIL, GAS OR WATER RECORDS

CASING RECORD

FORMATION	CONTENT	FROM	TO	SIZE	PUT IN	PULLED OUT
				8 5/8" OD	247'	None

Describe in detail the manner in which the well was plugged, indicating where the mud fluid was placed and the method or methods used in introducing it into the hole. If cement or other plugs were used, state the character of same and depth placed, from feet to feet for each plug set.

Mud up with heavy mud to 240', pushed down 1/3 sack hulls to 240'
followed by wooden plug. Placed 20 sacks cement through drill
pipe on to plug. Mud up to 35' and place 1/3 sack hulls at 35'
followed by wooden plug and 10 sacks cement to base of well cellar.

(If additional description is necessary, use BACK of this sheet)

Name of Plugging Contractor Garvey Drilling Company
Address Route 2, Great Bend, Kansas

STATE OF KANSAS, COUNTY OF BARTON, ss.
DON SEARLE (employee of owner) or (~~owner or operator~~) of the above-described well, being first duly sworn on oath, says: That I have knowledge of the facts, statements, and matters herein contained and the log of the above-described well as filed and that the same are true and correct. So help me God.

(Signature) Don Searle
Route 2, Great Bend, Kansas
(Address)

SUBSCRIBED AND SWORN to before me this 13 th day of February, 1957

My commission expires July 11, 1960

Scott S. Brown
Notary Public.

PLUGGING
FILE SEC. 16 T. 20 R. 12 W
BOOK PAGE 140 LINE 6

RECEIVED
STATE CORPORATION COMMISSION
FEB 14 1957 2-14-57
CONSERVATION DIVISION
Wichita, Kansas

WELL LOG

15.009.05809.0000

COMPANY PETROLEUM, INCORPORATED

SEC. 16 T. 20S R. 12W

FARM HULME 'F' NO. 1


LOC. SW,SE,NE

TOTAL DEPTH 3448'

COUNTY Barton Co., Kansas

COMM. February 1, 1957 COMP. February 10, 1957

CONTRACTOR GARVEY DRILLING COMPANY

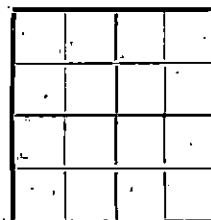

CASING 8 5/8" @ 247' W/225 sax.

ELEVATION 1838' DF

PRODUCTION D & A

FIGURES INDICATE BOTTOM OF FORMATIONS

10	Surface clay
40	Sand
200	Sand & shale
247	B lud shale
645	Shale & red bed
665	Anhydrite
1495	Shale & shells
1590	Shale & lime
2085	Lime
2820	Lime & shale
2860	Lime
3200	Shale & lime
3448	Lime
3448	T. D;

State of KANSAS }
County of BARTON } ss:

I, Verne A. Morris of Garvey Drilling Co.

upon oath state that the above and foregoing is a true and correct copy of the log of the #1 Hulme 'F' well

PLUGGING
FILE SEC 16 T. 20 R. 12W
BOOK PAGE 140 LINE 6

RECEIVED
STATE CORPORATION COMMISSION
Verne A. Morris

Subscribed and sworn to before me this 12th day of February 19 57

My Commission Expires: July 11, 1960

Jed Brown
NOTARY PUBLIC

