

WELL PLUGGING RECORD

OR

FORMATION PLUGGING RECORD


Strike out upper line when reporting plugging of formations.

STATE OF KANSAS STATE CORPORATION COMMISSION

Give All Information Completely Make Required Affidavit Mail or Deliver Report to: Conservation Division State Corporation Commission 806 Bitting Building Wichita, Kansas

Barton County. Sec. 16 Twp. 20 Rge. 12 (W) Location as "NE 1/4 NW 1/4 SW 1/4" or footage from lines SE SE NW Lease Owner J. L. Drilling Co. Inc. Lease Name Hulme Well No. 1 Office Address Character of Well (completed as Oil, Gas or Dry Hole) Dry Hole Date well completed 5-3-49 Application for plugging filed 5-3-49 Application for plugging approved 5-3-49 Plugging commenced 5-4-49 Plugging completed 5-4-49 Reason for abandonment of well or producing formation dry

NORTH

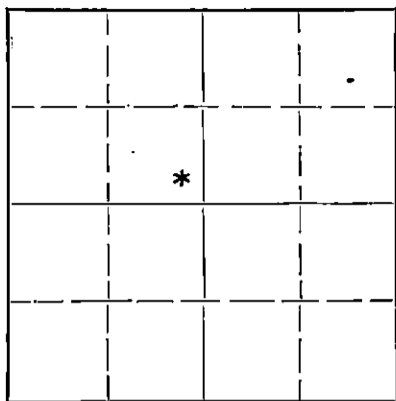

Locate well correctly on above Section Plat

Name of Conservation Agent who supervised plugging of this well C. D. Stough Producing formation Depth to top Bottom Total Depth of Well 3510 Feet Show depth and thickness of all water, oil and gas formations.

OIL, GAS OR WATER RECORDS

CASING RECORD

Table with 7 columns: Formation, Content, From, To, Size, Put In, Pulled Out. Entry: 8-5/8" Cimented with 200 sacks and circulated, Put In 364, Pulled Out None.

Describe in detail the manner in which the well was plugged, indicating where the mud fluid was placed and the method or methods used in introducing it into the hole. If cement or other plugs were used, state the character of same and depth placed, from 360 feet to 25 feet for each plug set. Filled with heavy mud to 360' and set one wood plug and 15 sacks cement on top of same, filled with heavy mud to 25' and 10 sacks of cement on top of same

RECEIVED

Conservation Div.

6-11-49 JUN 11 1949

STATE CORPORATION COMMISSION KANSAS

(If additional description is necessary, use BACK of this sheet)


Correspondence regarding this well should be addressed to Address

STATE OF KANSAS, COUNTY OF SEDGWICK, J. L. DRILLING COMPANY, INC. (employee of owner) or (owner or operator) of the above-described well, being first duly sworn on oath, says: That I have knowledge of the facts, statements, and matters herein contained and the log of the above-described well as filed and that the same are true and correct. So help me God.

(Signature) J. L. Drilling Co. Inc. 1316 Union National Bank Bldg., Wichita, Kansas (Address)

SUBSCRIBED AND SWORN to before me this 10th day of June, 1949 Leah J. Landrum Notary Public.

My commission expires March 25, 1952

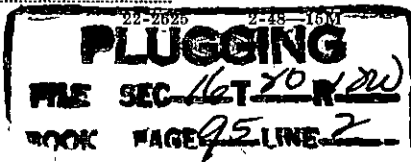

made
S.C.C.

To: John Linds
316 Union Natl. Bldg.
Wichita 2, Kansas

LEASE: Milne -1:

County: Barton, Kansas
Section: 16-20-12
Location: SE SE NW

Rotary: Total Depth 3510'
Commenced: 1-19-49; Completed 5-4-49
Casing: 365' of 3-5/8" None of 5-1/2"
Contractor: L-S-T Drilling Co. Inc.
1316 Union National Bank Building
Wichita 2, Kansas

Figures Indicate Bottom of Formation

0	To	120	Sand & Surface Clay
120		150	Sand & Gravel
150		175	Blue Shale
175-		270	Blue Shale & Sand
270		365	Red Bed & Sand Streaks
365		650	Red Bed & Shells
650		670	Anhydrite
670		1145	Red Bed & Shale & Shells
1145		1155	Shale & Shells
1155		1450	Salt & Shale
1450		1580	Shale & Lime
1580		1820	Lime & Shale
1820		1900	Lime
1900		1955	Lime & Shale Streaks
1955		2055	Lime & Shale
2055		2175	Shale & Lime
2175		2280	Shale, Lime & Shells
2280		2485	Shale & Shells
2485		2535	Shale & Lime
2535		2695	Shale & Shells
2695		2735	Lime & Shale
2735		3012	Lime
3012		3090	Broken Lime
3090		3445	Lime
3445		3470	Cherty Conglomerate
3470		3495	Dolomite
3495		3510	T. D. Lime (Dolomite)

STATE OF KANSAS
COUNTY OF SEDGWICK

I, the undersigned, being duly sworn on oath, state that the above statement and log is true and correct record and log of the well drilled at the location above described.

L-S-T DRILLING COMPANY, INC.,

By: Scott Stucky

Subscribed and sworn to before me this 7th day of May 1949

Catherine Sawyer
Notary Public

My Commission expires March 25, 1952

PLUGGING
FILE SEC 16-20-12
BOOK PAGE 95 LINE 2

RECEIVED
Conservation-Div.
JUN - 9 1949
STATE CORPORATION
COMMISSION
KANSAS