


WELL PLUGGING RECORD

Give All Information Completely  
Make Required Affidavit  
Mail or Deliver Report to:  
Conservation Division  
State Corporation Commission  
212 North Market, Insurance Bldg.  
Wichita, Kansas

NORTH

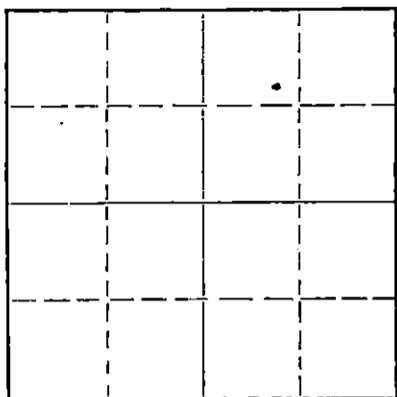

Locate well correctly on above  
Section Plat

Barton County. Sec. 16 Twp. 20 Rge. 12 (E) (W)  
Location as "NE/CNW/SW" or footage from lines SE NW NE  
Lease Owner Chas. Hulme Drilling Contractor  
Lease Name Hulme C Well No. 3  
Office Address P.O. Box 836, Great Bend, Kansas  
Character of Well (completed as Oil, Gas or Dry Hole) Dry Hole  
Date well completed 10-19 1961  
Application for plugging filed 10-19 1961  
Application for plugging approved 10-19 1961  
Plugging commenced 10-19 1961  
Plugging completed 10-19 1961  
Reason for abandonment of well or producing formation Dry Hole

If a producing well is abandoned, date of last production \_\_\_\_\_ 19\_\_\_\_  
Was permission obtained from the Conservation Division or its agents before plugging was commenced? Yes

Name of Conservation Agent who supervised plugging of this well Harold Hollis  
Producing formation \_\_\_\_\_ Depth to top \_\_\_\_\_ Bottom \_\_\_\_\_ Total Depth of Well 3480 Feet  
Show depth and thickness of all water, oil and gas formations.

OIL, GAS OR WATER RECORDS

CASING RECORD

FORMATION	CONTENT	FROM	TO	SIZE	PUT IN	PULLED OUT
Surface Pipe		0	216'	8 5/8	216'	0

Describe in detail the manner in which the well was plugged, indicating where the mud fluid was placed and the method or methods used in introducing it into the hole. If cement or other plugs were used, state the character of same and depth placed, from \_\_\_\_\_ feet to \_\_\_\_\_ feet for each plug set.

Bottom plug set at 200'. Dumped  
20 sacks of cement. Top plug  
set at 30'. Filled hole. 10 sacks of Cement

RECEIVED  
STATE CORPORATION COMMISSION

10-27-61 OCT 27 1961

CONSERVATION DIVISION  
Wichita, Kansas

(If additional description is necessary, use BACK of this sheet)

Name of Plugging Contractor Chas. Hulme Drilling Contractor  
Address P.O. Box 836, Great Bend, Kansas

STATE OF Kansas, COUNTY OF Barton, ss.  
C. E. Byars, Partner (employee of owner) or (owner or operator) of the above-described well, being first duly sworn on oath, says: That I have knowledge of the facts, statements, and matters herein contained and the log of the above-described well as filed and that the same are true and correct. So help me God.

(Signature) C. E. Byars  
P.O. Box 836, Great Bend, Kansas  
(Address)

SUBSCRIBED AND SWORN to before me this 25th day of November, 19 61

My commission expires 4-27-65

Virgil E. [Signature]  
Notary Public.



Chas. Hulme Drilling Contractor  
P. O. Box 836  
Great Bend Kansas

Hulme C-3

SE NW NE 16-20-12

Barton County, Kansas

0	- 215	Blue Clay	Elevation	1854'	DF
215	- 300	Shale		1857'	RB
300	- 670	Red bed	Anhydrite	663'	
670	- 685	Anhydrite	Hebner	3038'	-1181'
685	- 945	Shale & shells	Brown Lime	3163'	-1306'
945	- 1290	Shale	Kansas City	3177'	-1320'
1290	- 1535	Shale & shells	Conglomerate	3419'	-1562'
1535	- 1690	Shale & lime			
1690	- 2135	Lime			
2135	- 2265	Shale			
2265	- 2450	Lime & shale			
2450	- 2560	Shale			
2560	- 2885	Lime & shale			
2885	- 3079	Lime			
3079	- 3160	Lime & shale			
3160	- 3480	Lime			
3480		Rotary T D			

RECEIVED  
STATE CORPORATION COMMISSION

OCT 27 1961

CONSERVATION DIVISION  
Wichita, Kansas

Bottom plug set at 200'. Dumped 20 sacks of cement. Top plug set at 30'. Filled hole.

D & A

STATE OF KANSAS  
COUNTY OF BARTON ss

Virgil E. Belford, Jr., employee of Chas. Hulme Drilling Contractor, being first duly sworn on oath says: That I have knowledge of the facts, statement, and matters herein contained and the log of the above described well as filed and that the same are true and correct.

Virgil E. Belford, Jr.  
Virgil E. Belford, Jr.

Subscribed and sworn before me this 26th day of October 1961.

Jean Kimber  
Notary Public Barton County

My Commission Expires: 12-3-63