

STATE OF KANSAS
STATE CORPORATION COMMISSION

Form CP-4

Give All Information Completely
Make Required Affidavit
Mail or Deliver Report to:
Conservation Division
State Corporation Commission
212 No. Market
Wichita, Kansas 67202


WELL PLUGGING RECORD

BARTON County, Sec. 16 Twp. 20s Rge. 12 (W)
Location as "NE/CNW/SW" or footage from lines N/2 SW NW
Lease Owner PETROLEUM, INC.,
Lease Name HULME 'D' Well No. 3
Office Address R.R. #2, GREAT BEND, KANSAS
Character of Well (completed as Oil, Gas or Dry Hole) DRY HOLE
Date well completed AUG. 4 1971
Application for plugging filed AUG. 4 1971
Application for plugging approved AUG. 4 1971
Plugging commenced AUG. 4 1971
Plugging completed AUG. 4 1971
Reason for abandonment of well or producing formation NO COMMERCIAL ZONE

If a producing well is abandoned, date of last production NONE 19
Was permission obtained from the Conservation Division or its agents before plugging was commenced? YES

Name of Conservation Agent who supervised plugging of this well DONALD TRUAN
Producing formation _____ Depth to top _____ Bottom _____ Total Depth of Well 3450 Feet

Show depth and thickness of all water, oil and gas formations.

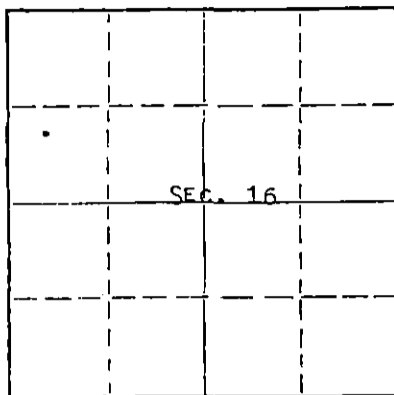

Locate well correctly on above Section Plat

OIL, GAS OR WATER RECORDS

CASING RECORD

FORMATION	CONTENT	FROM	TO	SIZE	PUT IN	PULLED OUT
				8-5/8"	236'	NONE

Describe in detail the manner in which the well was plugged, indicating where the mud fluid was placed and the method or methods used in introducing it into the hole. If cement or other plugs were used, state the character of same and depth placed, from _____ feet to _____ feet for each plug set.

HEAVY MUD TO 480', WOODEN PLUG, PLACED 40 SACKS CEMENT ON TOP OF PLUG.
HEAVY MUD TO 210', WOODEN PLUG, PLACED 25 SACKS CEMENT ON TOP OF PLUG.
HEAVY MUD TO 40', WOODEN PLUG, 1/2 SACK HULLS AND 10 SACKS CEMENT ON TOP OF PLUG TO BASE OF WELL CELLAR.

RECEIVED
STATE CORPORATION COMMISSION
AUG 9 1971
CONSERVATION DIVISION
Wichita, Kansas

Name of Plugging Contractor GARVEY DRILLING COMPANY
Address R.R. #2, GREAT BEND, KANSAS

STATE OF KANSAS, COUNTY OF BARTON, ss.
MONTE CHADD (employee of owner) or (owner/operator) of the above-described well, being first duly sworn on oath, says: That I have knowledge of the facts, statements, and matters herein contained and the log of the above-described well as filed and that the same are true and correct. So help me God. MONTE CHADD, DIST. PROD. SUPT.

(Signature) Monte Chadd
R.R. #2, GREAT BEND, KANSAS
(Address)

Subscribed and sworn to before me this 6 day of AUGUST, 1971

Richard A. Dunbar
Notary Public.

WELL LOG

15.009.20604.0000

COMPANY Petroleum, Inc.

SEC. 16 T. 20S R. 12W

FARM Hulme "D"

NO. 3

LOC. N/2 SW NW

TOTAL DEPTH 3450'

COUNTY Barton, Kansas

COMM. 7-28-71

COMP. 8-4-71

CONTRACTOR Garvey Drilling Company

CASING

8 5/8" @ 236' w/225sx

ELEVATION 1846 DF

PRODUCTION D & A

FIGURES INDICATE BOTTOM OF FORMATIONS

- . 45' Sand
- 236' Sand & Shale
- .640' Shale & Red Bed
- .676' Red Bed & Shale
- .685' Anhydrite
- .1500' Shale
- .1770' Shale & Lime
- 2025' Lime & Shale
- 2425' Shale & Lime
- 2890' Shale & Shells
- 2935' Lime & Shale
- 3040' Shale & Lime
- 3285' Lime
- .3443' Arbuckle
- 3450' Arbuckle
- 3450' RTD

RECEIVED
STATE CORPORATION COMMISSION
AUG 9 1971
CONSERVATION DIVISION
Wichita, Kansas

State of Kansas }
County of Barton } ss

I, Charlene Marker of Garvey Drilling Company
upon oath state the above and foregoing is a true and correct copy of the log of the Hulme "D" #3 well.

Subscribed and sworn to before me this 5th day of August 19 71

My Commission Expires: July 8, 1974

Sam A. Morris
NOTARY PUBLIC