


STATE OF KANSAS  
STATE CORPORATION COMMISSION

WELL PLUGGING RECORD

Give All Information Completely  
Make Required Affidavit  
Mail or Deliver Report to:  
Conservation Division  
State Corporation Commission  
211 No. Broadway  
Wichita, Kansas

BARTON County. Sec. 16 Twp 20S Rge. 12 (E) W (W)  
Location as "NE/CNW/SW" or footage from lines SW NW SE  
Lease Owner PETROLEUM INC.  
Lease Name HULME "I" Well No. 3  
Office Address Route 2, Great Bend, Kansas  
Character of Well (completed as Oil, Gas or Dry Hole) Dry Hole  
Date well completed December 12 19 56  
Application for plugging filed December 12 19 56  
Application for plugging approved December 12 19 56  
Plugging commenced December 12 19 56  
Plugging completed December 12 19 56  
Reason for abandonment of well or producing formation No Producing Zones

NORTH

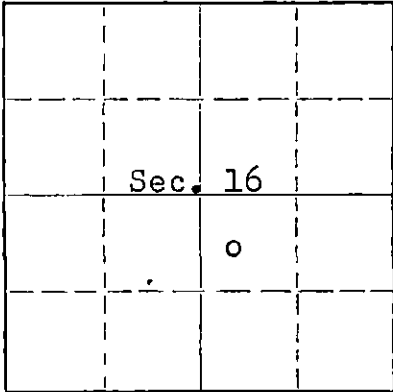

Locate well correctly on above Section Plat

If a producing well is abandoned, date of last production None 19  
Was permission obtained from the Conservation Division or its agents before plugging was commenced? Yes

Name of Conservation Agent who supervised plugging of this well R. M. Brundage, Hoisington, Kansas  
Producing formation ----- Depth to top -- Bottom -- Total Depth of Well 3492 Feet  
Show depth and thickness of all water, oil and gas formations.

OIL, GAS OR WATER RECORDS

CASING RECORD

FORMATION	CONTENT	FROM	TO	SIZE	PUT IN	PULLED OUT
				8 5/8" OD	247'	None

Describe in detail the manner in which the well was plugged, indicating where the mud fluid was placed and the method or methods used in introducing it into the hole. If cement or other plugs were used, state the character of same and depth placed, from \_\_\_\_\_ feet to \_\_\_\_\_ feet for each plug set.

Mud up with heavy mud to 240', pushed down 1/4 sack hulls to 240' followed by wooden plug. Placed 20 sacks cement through drill pipe on to plug. Mud up to 35' and place 1/4 sack hulls at 35' followed by wooden plug and 10 sacks cement to base of well cellar.

12-28-56

RECEIVED  
STATE CORPORATION COMMISSION

DEC 28 1956

CONSERVATION DIVISION  
Wichita, Kansas

(If additional description is necessary, use BACK of this sheet)

Name of Plugging Contractor Garvey Drilling Co.  
Address Route 2, Great Bend, Kansas

STATE OF KANSAS, COUNTY OF BARTON, ss.  
DON SEARLE (employee of owner) or (XXXXXX) of the above-described well, being first duly sworn on oath, says: That I have knowledge of the facts, statements, and matters herein contained and the log of the above-described well as filed and that the same are true and correct. So help me God.

(Signature) Don Searle

(Address)

SUBSCRIBED AND SWORN TO before me this 26 th day of December, 19 56

Ed J. Brown  
Notary Public.

My commission expires July 11, 1960

PLUGGING  
FIL SEC 16 T. 20 R. 12W  
BOOK PAGE 125 LINE 22

# WELL LOG

15.009.05811.0000

COMPANY PETROLEUM, INCORPORATED

SEC. 16 T20S R. 12W

FARM Hulme 'I' NO. 3


LOC. SW,NW,SE

TOTAL DEPTH 3492'

COUNTY Barton Co., Kansas

COMM. December 3, 1956 COMP. December 12, 1956

CONTRACTOR GARVEY DRILLING COMPANY

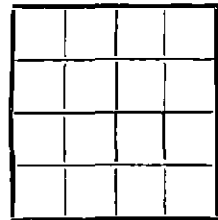

CABING 8 5/8" @ 247' W/200 sax.

ELEVATION 1840' DF

PRODUCTION D & A

FIGURES INDICATE BOTTOM OF FORMATIONS

190	Surface soil & sand
247	Blue Shale
645	Red bed
665	Anhydrite
910	Shale & shells
2805	Lime & shale
2981	Lime
3195	Lime & shale
3409	Lime
3447	Conglomerate
3472	Conglomerate W/chert
3492	Arbuckle lime
3492	T. D.

RECEIVED  
STATE COMMISSION  
DEC 23 1956

State of KANSAS  
County of BARTON

PLUGGING  
FILE SEC 16 T 20 R 12W  
BOOK PAGE 125 LINE 22

I, Verne A. Morris of Garvey Drilling Co.

upon oath state that the above and foregoing is a true and correct copy of the log of the Hulme 'I' #3 well

Verne A. Morris

Subscribed and sworn to before me this 26th day of Dec ember 19 56

My Commission Expires: July 11, 1960

[Signature]  
NOTARY PUBLIC