

STATE OF KANSAS  
STATE CORPORATION COMMISSION

Give All Information Completely  
Make Required Affidavit  
Mail or Deliver Report to:  
Conservation Division  
State Corporation Commission  
212 No. Market  
Wichita, Kansas 67202

WELL PLUGGING RECORD

Barton County, Sec. 24 Twp. 20S Rgo. 11  (W)

Location as "NE/CNW/SW" or footage from lines NW SW SE  
Lease Owner Mobil Oil Corporation  
Lease Name H. J. Roetzel "B" Well No. 11  
Office Address P. O. Box 1934, Oklahoma City, Oklahoma 73101  
Character of Well (completed as Oil, Gas or Dry Hole) Oil  
Date well completed August 18 19 67  
Application for plugging filed November 16 19 73  
Application for plugging approved November 20 19 73  
Plugging commenced April 15 19 74  
Plugging completed May 16 19 74  
Reason for abandonment of well or producing formation Formation Depleted

If a producing well is abandoned, date of last production August 18 19 66  
Was permission obtained from the Conservation Division or its agents before plugging was commenced? yes

Name of Conservation Agent who supervised plugging of this well Donald Truan  
Producing formation Lansing-Kansas City Depth to top 3042 Bottom 3065 Total Depth of Well 3254 Feet  
Show depth and thickness of all water, oil and gas formations.

OIL, GAS OR WATER RECORDS

CASING RECORD

FORMATION	CONTENT	FROM	TO	SIZE	PUT IN	PULLED OUT
Arbuckle	Oil	3246	3254	13"	200'	None
Lansing-Kansas City	Oil	3242	3065	7"	3244'	1620'

Describe in detail the manner in which the well was plugged, indicating where the mud fluid was placed and the method or methods used in introducing it into the hole. If cement or other plugs were used, state the character of same and depth placed, from \_\_\_\_\_ feet to \_\_\_\_\_ feet for each plug set.

Filled hole w/sand from 3220-3030' & capped sand w/5sacks cement from 3030' - 3000'. Shot pipe at 2020', 1713', 1620'. Recovered 7" casing from 1620'. Allied cemented hole w/1 sack of hulls, 25 sacks of gel mud and 150 sacks cement in 13" casing to plug well.

RECEIVED  
STATE CORPORATION COMMISSION

JUN 7 1974

CONSERVATION DIVISION  
Wichita, Kansas

6-7-1974

(If additional description is necessary, use BACK of this sheet)

Name of Plugging Contractor Ralph Glenn  
Address 204 E. 6th, Ellinwood, Kansas 67526


STATE OF Oklahoma, COUNTY OF Oklahoma, ss.  
Paul K. Langenberg (employee of owner) or (owner or operator) of the above-described well, being first duly sworn on oath, says: That I have knowledge of the facts, statements, and matters herein contained and the log of the above-described well as filed and that the same are true and correct. So help me God.

(Signature) Paul K. Langenberg  
Box 1934, Okla. City, Okla. 73101  
(Address)

SUBSCRIBED AND SWORN TO before me this 4th day of June, 19 74

Richard M. Aguib  
Notary Public.

My commission expires 11-17-77

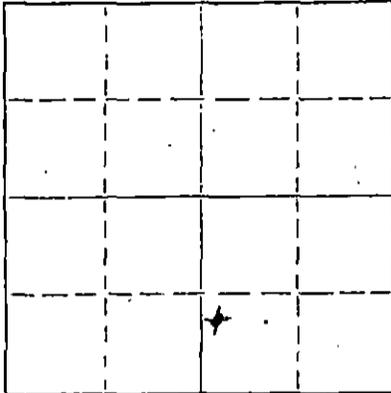

Locate well correctly on above Section Plat

RECORD OF WELL NO. 11

MAGNOLIA PETROLEUM COMPANY

H. J. Roetzel Farm

NW SW SE Sec. 24-20S-11W

Barton County, Kansas

Rig Commenced	7-23-37	Rig Completed	7-24-37
Drilling Commenced	7-24-37	Drilling Completed	8-18-37

Casing Record	Put In	Left In	
13" OD 40# Lapweld	200	200	Cemented w/225 Sacks
7" OD 24# Seamless	3244	3244	Cemented w/250 Sacks

Production - 1764 Bbls. Potential

<u>Formation</u>	<u>Depth</u>
cellar	8
sand	74
red bed & shells	200
13" OD Csg. Set	200
red bed & shells	360
red bed & shale	760
shale, shells & salt	1200
shale & lime	1560
shale & sand	1650
lime	1710
shale & lime	1850
shale & shells	2070
shale & lime	2205
shale	2300
shale & lime	2515
lime	2815
lime & shale	2870
lime	3236
lime-cored	3245
Top Arbuckle Lime	3243 SLM
7" OD Csg. Set	3244 SLM
Standardized	
Arbuckle Lime	3246
Arbuckle Lime-cored	3254
Total Depth SLM	3254

RECEIVED  
STATE CORPORATION COMMISSION  
NOV 19 1973  
CONSERVATION DIVISION  
Wichita, Kansas