

REW

15.009.14703.0000

STATE OF KANSAS
STATE CORPORATION COMMISSION

Form CP-4

Give All Information Completely
Make Required Affidavit
Mail or Deliver Report to:
Conservation Division
State Corporation Commission
212 No. Market
Wichita, Kansas 67202


WELL PLUGGING RECORD

Barton County. Sec. 24 Twp 20S Rgo. 11 (~~W~~) (W)

Location as "NE/CNW&SW" or footage from lines. SW NW SE
Lease Owner Mobil Oil Corporation
Lease Name H. J. Roetzel "B" Well No. 8
Office Address P. O. Box 1934, Oklahoma City, Oklahoma 73101
Character of Well (completed as Oil, Gas or Dry Hole) Oil
Date well completed June 23 1974
Application for plugging filed April 9 1974
Application for plugging approved _____ 19____
Plugging commenced May 3 1974
Plugging completed May 16 1974
Reason for abandonment of well or producing formation Formation depleted.

If a producing well is abandoned, date of last production May 28 1966
Was permission obtained from the Conservation Division or its agents before plugging was commenced? _____

Name of Conservation Agent who supervised plugging of this well Donald Truan
Producing formation Lansing-Kansas City Depth to top 3016 Bottom 3067 Total Depth of Well 3252 Feet
Show depth and thickness of all water, oil and gas formations.

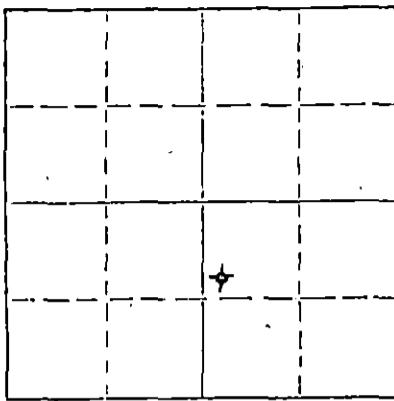

Locate well correctly on above Section Plat

OIL, GAS OR WATER RECORDS

CASING RECORD

FORMATION	CONTENT	FROM	TO	SIZE	PUT IN	PULLED OUT
Arbuckle	Oil	3232	3252	13"	192'	None
Lansing-Kansas City	Oil	3016	3067	7"	3242'	1590'

Describe in detail the manner in which the well was plugged, indicating where the mud fluid was placed and the method or methods used in introducing it into the hole. If cement or other plugs were used, state the character of same and depth placed, from _____ feet to _____ feet for each plug set.
Filled hole with sand from 3096'-3000' and capped sand w/5 sacks cement from 3000'-2980'. Shot 7" casing at 1713' & 1590'. Recovered 7" casing from 1590'. Allied plugged hole w/1 sack of hulls, 25 sacks of gel mud & 150 sacks cement in 13" casing.

RECEIVED
STATE CORPORATION COMMISSION
JUN 7 1974
CONSERVATION DIVISION
Wichita, Kansas
6-7-1974

(If additional description is necessary, use BACK of this sheet)
Name of Plugging Contractor Ralph Glenn
Address 204 E. 6th, Ellinwood, Kansas 67526

STATE OF Oklahoma, COUNTY OF Oklahoma, ss.
Paul K. Langenberg (employee of owner) or (owner or operator) of the above-described well, being first duly sworn on oath, says: That I have knowledge of the facts, statements, and matters herein contained and the log of the above-described well as filed and that the same are true and correct. So help me God.

(Signature) Paul K. Langenberg
Box 1934, Oklahoma City, Oklahoma 73101
(Address)

SUBSCRIBED AND SWORN TO before me this 4th day of June, 1974

My commission expires 11-17-77
Richard M. Aguirre Notary Public.

RECORD OF WELL NO. 8

MAGNOLIA PETROLEUM COMPANY

15.009.14703.0000

H. J. Roetzel Farm

SW NW SE Sec. 24-20S-11W
Barton County, Kansas

Rig Commenced 5-27-37
Drilling Commenced 6-1-37

Rig Completed 5-29-37
Drilling Completed 6-23-37

Casing Record	Put In	Left In	
13" OD 40# Lapweld	192	192	Cemented w/200 Sacks
7" OD 24# Seamless	3242	3242	Cemented w/250 Sacks

Production - 2720 Bbls. Potential

Formation	Depth
cellar	7
sand	60
shale	150
red bed	192
13" OD Csg. Set	192
red bed & shale	570
shale & shells	950
salt	1230
shale & shells	1285
shale & lime	1560
shale & sand	1655
lime	1720
shale & shells	1750
lime shells & shale	1850
shale & shells	1945
lime & shale	2025
shale & shells	2340
lime & shale	2420
shale	2490
shale & lime shells	2615
shale & lime	2724
lime	2780
shale & lime	2830
lime	2910
shale & lime	3040
lime	3239
Top Lansing	3005
cored lime	3239
Top Arbuckle Lime	3242 SLM
7" OD Csg. Set	3242 SLM

Standardized
Arbuckle Lime-cored 3252
Total Depth - SLM 3252