


WELL PLUGGING RECORD

Give All Information Completely  
Make Required Affidavit  
Mail or Deliver Report to:  
Conservation Division  
State Corporation Commission  
212 No. Market  
Wichita, Kansas

Barton County, Sec. 24 Twp. 20 Rge. (E) 11 (W)

Location as "NE/CNW&SW&" or footage from lines CNL S/2 NWW  
Lease Owner Specter Pipe & Supply, Inc.  
Lease Name Peters Well No. 1  
Office Address Box 169, Russell, Kans.  
Character of Well (completed as Oil, Gas or Dry Hole) oil  
Date well completed 12-22-36 19    
Application for plugging filed 8-18-69 19    
Application for plugging approved 8-19-69 19    
Plugging commenced 9/15 1969  
Plugging completed 9/23 1969  
Reason for abandonment of well or producing formation Depleted

NORTH

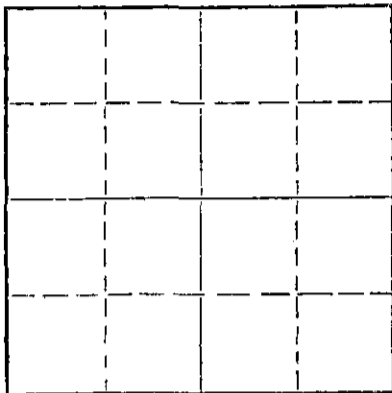

Locate well correctly on above  
Section Plat

If a producing well is abandoned, date of last production    19    
Was permission obtained from the Conservation Division or its agents before plugging was commenced? Yes

Name of Conservation Agent who supervised plugging of this well Don Truan  
Producing formation arbuckle Depth to top 3247 Bottom 3258 Total Depth of Well 3258 Feet  
Show depth and thickness of all water, oil and gas formations.

OIL, GAS OR WATER RECORDS

CASING RECORD

FORMATION	CONTENT	FROM	TO	SIZE	PUT IN	PULLED OUT
				12 1/2"	218'	none
				7"	3247 3/8'	1621'

Describe in detail the manner in which the well was plugged, indicating where the mud fluid was placed and the method or methods used in introducing it into the hole. If cement or other plugs were used, state the character of same and depth placed, from    feet to    feet for each plug set.

Plugged back to 3200' with sand, dumped 5 sacks cement, circulated mud to 500', dumped 35 sacks cement to 400', dumped 35 sacks cement to 200', set 10' rock bridge to 30', dumped 15 sacks cement.

10-1-1969  
RECEIVED  
STATE CORPORATION COMMISSION  
OCT 1 1969  
CONSERVATION DIVISION  
Wichita, Kansas

(If additional description is necessary, use BACK of this sheet)

Name of Plugging Contractor Lynch Casing Pulling Co  
Address Rt 4, Great Bend, Ks

STATE OF Kansas, COUNTY OF Russell, ss.  
Specter Pipe & Supply, Inc. (employee of owner) or (owner or operator) of the above-described well, being first duly sworn on oath, says: That I have knowledge of the facts, statements, and matters herein contained and the log of the above-described well as filed and that the same are true and correct. So help me God.

(Signature) [Signature]  
Russell, Kansas  
(Address)

SUBSCRIBED AND SWORN TO before me this 29<sup>th</sup> day of September, 1969

My commission expires May 21, 1971

Wilma M. Lindahl  
Notary Public.

15.609.14678.0000

IND. TERR. ILL. OIL CO.  
Peters No. 1.

SEC. 24 T. 20 R. 11W  
ONL S/2 NW

Total Depth. 3258'  
Comm. 11-18-36 Comp. 12-22-36  
Shot or Treated.  
Contractor.  
Issued. 1-16-37

County. Barton

CASING:  
12 1/2" 218'  
7" 3247 1/2'



Elevation.

Production. Pot. 1964 B.

Figures Indicate Bottom of Formations.

sand	65
sand & shells	100
shale	138
red rock	188
sand	197
red rock	205
shells	207
red rock & shells	214
red rock & shells	472
lime	498
red rock & shells	636
red rock	733
red rock & shells	958
red rock & shale	1210
shale	1245
brkn lime	1445
shale & shells	1515
brkn lime	1573
shale & shells	1580
brkn lime	1634
shale	1849
brkn lime	1689
sdv lime	1725
brkn lime	1735
red rock & shale	1830
lime	1850
shale & lime shells	1898
lime	1970
sdv lime	1995
brkn lime	2030
red rock & shells	2045
brkn sand	2060
shale & shells	2330
lime	2414
shale & shells	2494
brkn lime	2533
red rock & shale	2577
shale	2580
lime	2667
lime & shale	2721
lime	2882
shale & shells	2945
shale	2952
shale	2961
shale & shells	2989
lime	3060
sticky shale & shells	3075
lime	3095
show of oil	3090-95
lime	3242
lime	3247
shale	3248
dolomite	3258
Total Depth	3258

RECEIVED  
STATE CORPORATION COMMISSION  
AUG 18 1969  
CONSERVATION DIVISION  
Wichita, Kansas