


STATE OF KANSAS
STATE CORPORATION COMMISSION

WELL PLUGGING RECORD

Give All Information Completely
Make Required Affidavit
Mail or Deliver Report to:
Conservation Division
State Corporation Commission
212 No. Market
Wichita, Kansas

NORTH

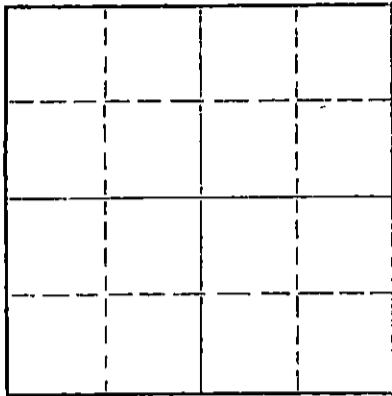

Locate well correctly on above
Section Plat

Barton County, Sec 24 Twp. 20 Rge. 11 (E) (W)
Location as "NE/CNW%SW%" or footage from lines N/2 S/2 SW
Lease Owner Bulldog Pipe & Supply
Lease Name Sessler Well No. A-2
Office Address 309 Mayo Building Tulsa, Oklahoma
Character of Well (completed as Oil, Gas or Dry Hole) _____
Date well completed _____ 19____
Application for plugging filed 7-23-69 19____
Application for plugging approved 7-24-69 19____
Plugging commenced 8-5-69 19____
Plugging completed 8-11-69 19____
Reason for abandonment of well or producing formation _____

If a producing well is abandoned, date of last production _____ 19____
Was permission obtained from the Conservation Division or its agents before plugging was commenced? Yes

Name of Conservation Agent who supervised plugging of this well Donald Truan
Producing formation _____ Depth to top _____ Bottom _____ Total Depth of Well 3254 Feet
Show depth and thickness of all water, oil and gas formations.

OIL, GAS OR WATER RECORDS

CASING RECORD

FORMATION	CONTENT	FROM	TO	SIZE	PUT IN	PULLED OUT
				10 3/4	231	None
				7	None	1641

8-14-1969
RECEIVED
STATE CORPORATION COMMISSION
AUG 14 1969
CONSERVATION DIVISION
Wichita, Kansas

Describe in detail the manner in which the well was plugged, indicating where the mud fluid was placed, the method or methods used in introducing it into the hole. If cement or other plugs were used, state the character of same and depth placed from _____ feet to _____ feet for each plug set.

Cleaned out cellar. Moved in. Rigged up unit. Working pipe. Sanded to 3225'. Dumped 6 sacks of cement.
Working pipe. Shot pipe at 2200' - 2000' - 1800' - 1700' and 1630'.
Working pipe. Shot pipe at 1565'. Pulling pipe.
Pushed plug to 198'. Dumped 10 sacks of cement. Bailed hole down.
Dumped 4 yards of ready mix cement.

(If additional description is necessary, use BACK of this sheet)

Name of Plugging Contractor Forbes Casing Pulling Company, Inc.
Address P. O. Box 221 Great Bend, Kansas 67530

STATE OF Kansas, COUNTY OF Barton, ss.
James W. Rockhold (employee of owner) or (owner or operator) of the above-described well, being first duly sworn on oath, says: That I have knowledge of the facts, statements, and matters herein contained and the log of the above-described well as filed and that the same are true and correct. So help me God.
(Signature) James W. Rockhold
P. O. Box 221 Great Bend, Kansas
(Address)

SUBSCRIBED AND SWORN TO before me this 12 day of August, 19 69

My commission expires May 27, 1973

Glenn [Signature]
Notary Public.

COPY


WELL LOG BUREAU - KANSAS GEOLOGICAL SOCIETY
412 Union National Bank Bldg, Wichita, Kansas.

IND. TERR. ILL. OIL CO.
R. Sessler No. 2

SEC. 24 T. 20 R. 11W.
CNL S₃ SW
990' SL 1320' fr W.L.

Total Depth. 3254
Comm. 8-11-37 Comp. 8-28-37
Shot or Treated.
Contractor. Arrow Drlg Co.
Issued. 11-20-37

County Barton.

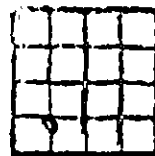

CASING. Rotary and Cable.

103/4" 231'
7" 3243'

Elevation.

Production. Pot. 1086 B.
1st 8 hrs.

Figures Indicate Bottom of Formations.

sand	100
shale	232
shale and shells	1050
salt and shale	1245
shale and shells	1337
shale and lime	1454
lime and shale	1530
sand and shale	1632
sdv lime	1709
shale and shells	1797
shale	1890
lime and shale	2055
shale and lime shells	2300
shale and lime	2388
shale and shells	2472
shale and lime shells	2596
lime and shale	2668
lime	2696
sand	2715
lime	2875
lime and shale	2937
lime	3242
dolomite soft	3253
dolomite hard	3254
Total Depth.	

RECEIVED
STATE CONSERVATION COMMISSION
JUL 24 1969
CONSERVATION DIVISION
Wichita, Kansas

Stool line measurement 3028